IREDELL COUNTY HEALTH DEPARTMENT

STATE 704-878-5305 138.00 Paid MOORESVILLE 704-664-5281 1.00

IMPROVEMENT PERMIT / AUTHORIZATION TO CONSTRUCT / OPERATION PERMIT / EXISTING SYSTEM INSPECTION

PERMIT# 119167 PIN# 4655-45-0057 DATE

OWNER OR CONTRACTOR Moser Bros. Inc PHONE: Business 704-634-9703 Home

ADDRESS 119 Barber Lp. Mooresville NC 28117

LOCATION 1153, TL Faith, TR Midway LK Rd, TR Tradition 2nd on Lt.

SUBDIVISION The Home Place BLOCK / SECTION LOT 6 LOT AREA 2.17 Ac SITE CLASS. PS DESIGN FLOW 600 L.T.A.R. 0.3

Septic Tank: ~~1500~~ 1550 Gallons; STB 2168 Date

Pump Tank: Gallons; PT Date

Pump Make: Model Serial No.

Nitrification Field: No Fields 1 Square Feet 1500 Linear Feet 500

No Lines 5 @ 100' Trench Width 36" Max Trench Bottom Depth 36" Gravel Depth —

☒ New System ☐ Repair System Type: I, II, (III) IV, V, VI

System Description: Gravity 25% Reduct

Repair System Description: Same

Maintenance Agreement Required: ☐ Yes ☒ No

☒ House/Mod. Home No. Bedrooms 5

☐ Mobile Home No. Bathrooms 5½

☐ Business No. Employees

☐ Other

☐ Slab ☒ Crawl Space ☐ Basement w/plumbing ☐ Basement wo/plumbing


Water Supply: ☒ Individual ☐ Public ☐ Community

Comments:/Conditions:

1" = 100'

Comments:/Conditions:

INITIAL SITE SKETCH

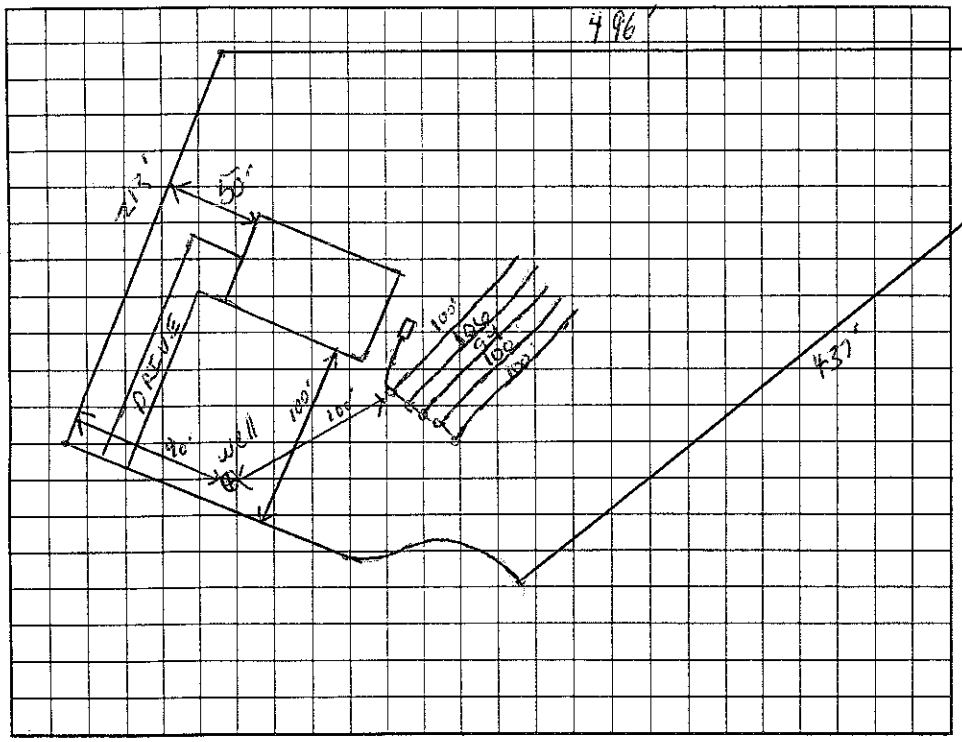

AS BUILT SKETCH

Installed as Drawn
Used "Plastic Chambers"

Permit can be suspended or revoked if any false information is supplied toward securing the permit/any unauthorized changes are made to the site/any unauthorized changes are made in the installation of the system. Improvement Permit with plat valid without expiration. Improvement Permit with site plan valid for sixty months. Authorization to Construct is valid for a period equal to that of Improvement Permit – not to exceed sixty months.

Signed: date 3-22-04

Improvement Permit by: RS date 3/15/04

Authorization to Construct by: RS date 3/15/04

Installed by: A & S Grading

Operation Permit by: RS date 9/14/04

Existing System Inspection by: date

HEALTH DEPT. COPY: WHITE OWNER COPY (FINAL): YELLOW OWNER COPY (INITIAL): PINK