IREDELL COUNTY H[illegible]H DEPARTMENT

STATESVILLE 704-878-5305 MOORESVILLE 704-664-5281

#130 2130

IMPROVEMENT PERMIT / AUTHORIZATION TO CONSTRUCT / OPERATION PERMIT / EXISTING SYSTEM INSPECTION

PERMIT# 103276 PIN# ~~4655-35-5889~~ 4655 45 1654 DATE 5/19/03

OWNER OR CONTRACTOR Moser Bros. Inc. PHONE: Business 704-634-9793 Home

ADDRESS 119 Barber Ln. Mooresville NC 28117

LOCATION 1155 TL Faith Rd, TR Midway Lk, TR on New TRL

SUBDIVISION The Home Place BLOCK / SECTION ____ LOT 12 LOT AREA 3.0 AC SITE CLASS. AS DESIGN FLOW 600 L.T.A.R. 0.35

Septic Tank: 1500 Gallons; STB 338 Date 8/11/03
Pump Tank: ____ Gallons; PT ____ Date ____
Pump Make: ____ Model ____ Serial No. ____
Nitrification Field: No Fields 1 Square Feet 1290 Linear Feet 430'
No Lines 4 Trench Width 36" Max Trench Bottom Depth 36" Gravel Depth —

☒ New System ☐ Repair System Type: I. II. III. IV. V. VI.
System Description: Gravity 25% Reduct.
Repair System Description: Same
Maintenance Agreement Required: ☐ Yes ☒ No

☒ House/Mod. Home No. Bedrooms 5
☐ Mobile Home No. Bathrooms ____
☐ Business No. Employees ____
☐ Other ____


☐ Slab ☒ Crawl Space ☐ Basement w/plumbing ☐ Basement wo/plumbing

Water Supply: ☒ Individual ☐ Public ☐ Community


Comments:/Conditions: Install Drain Lines on Contour

Comments:/Conditions:

INITIAL SITE SKETCH 1"=100'

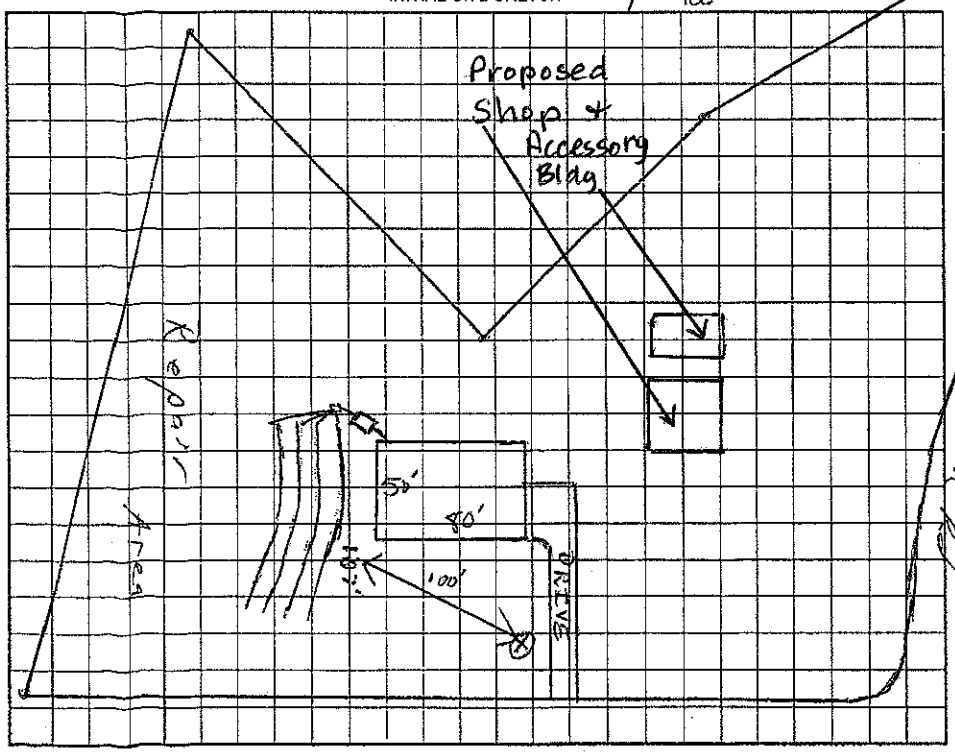

AS BUILT SKETCH

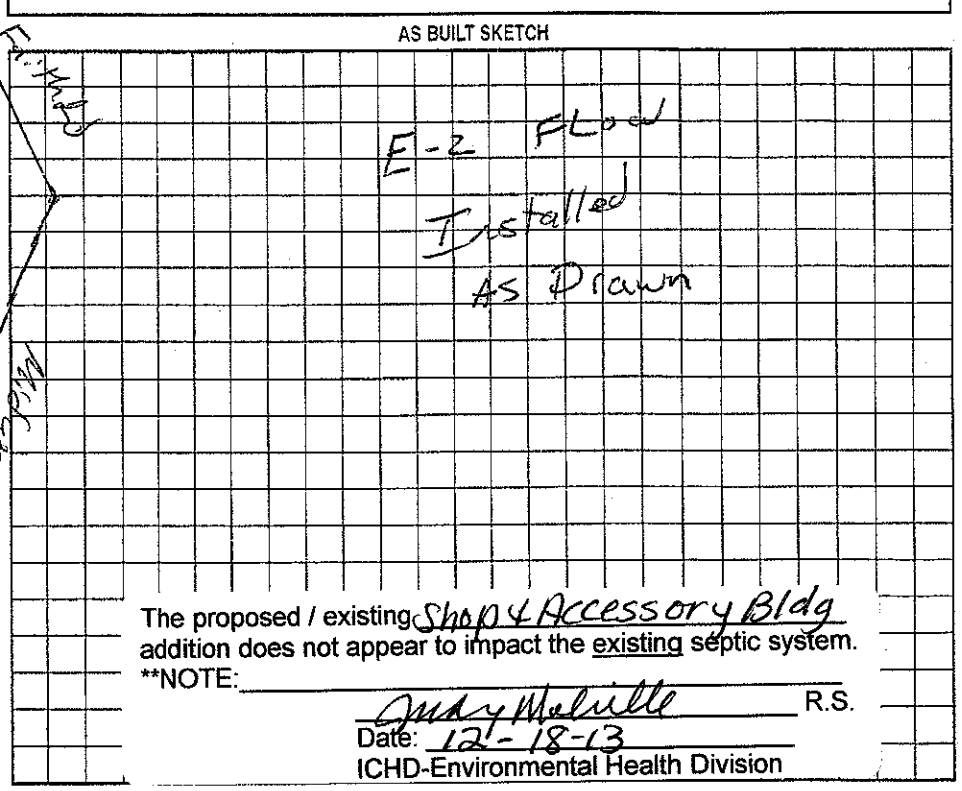

The proposed / existing Shop & Accessory Bldg addition does not appear to impact the existing septic system.

**NOTE: ____

Judy Melville R.S.
Date: 12-18-13
ICHD-Environmental Health Division

Permit can be suspended or revoked if any false information is supplied toward securing the permit/any unauthorized changes are made to the site/any unauthorized changes are made in the installation of the system. Improvement Permit with plat valid without expiration. Improvement Permit with site plan valid for sixty months. Authorization to Construct is valid for a period equal to that of Improvement Permit – not to exceed sixty months.

Signed: [signature] date ____

Improvement Permit by: [signature] RS date 5/19/03

Authorization to Construct by: [signature] RS date 5/19/03

Installed by: FJ Ervin

Operation Permit by: [signature] RS date 9/16/03

Existing System Inspection by: ____ date ____