4102

IREDELL COUNTY HEALTH DEPARTMENT

STATESVILLE 704-878-5305 MOORESVILLE 704-664-5281

IMPROVEMENT PERMIT / AUTHORIZATION TO CONSTRUCT / OPERATION PERMIT / EXISTING SYSTEM INSPECTION

PERMIT# 119683 PIN# 4655453351 DATE 11-3-06

OWNER OR APPLICANT George Moser PHONE: Business 704-634-9703 Home

ADDRESS 119 Barber Loop Mooresville 28117

LOCATION 115 S TL Faith TR Midway Lake TR Tradition on left corner Address: 113 Tradition Pl

SUBDIVISION The Homeplace BLOCK / SECTION LOT 1 LOT AREA 2.23 Ac SITE CLASS. PS DESIGN FLOW 480gpd L.T.A.R. .3 gpd / ft²

Septic Tank: 1000 Gallons: STB 1007 Date 4-16-07
Pump Tank: Gallons: PT Date
Pump Make: Model Serial No.
Nitrification Field: No Fields 1 Square Feet 1600 Linear Feet 400
No Lines 4 @ 100' Trench Width 36" Max Trench Bottom Depth 36"

☒ New System ☐ Repair ☐ Expansion System Type: I (II) III IV V VI
System Description: 25% reduction gravity
Repair System Description: LP Panel
Maintenance Agreement Required: ☐ Yes ☒ No

☒ House/Mod. Home No. Bedrooms 4
☐ Mobile Home No. Persons 8
☐ Business No. Employees
☐ Other

Water Supply: ☒ Individual ☐ Public ☐ Community


Gravel Depth NA ☒ Gravity ☐ Pressure ☐ Slab ☒ Crawl Space ☐ Basement w/plumbing ☐ Basement wo/plumbing

Comments:/Conditions: Flow splitter such as Zoeller for 4 lines equal distribution
shop plumbing connected to house.
well 25' from buildings

Comments:/Conditions: 6/13/07 Okay to use Drop box or Dist. box

1" = 100'

INITIAL SITE SKETCH

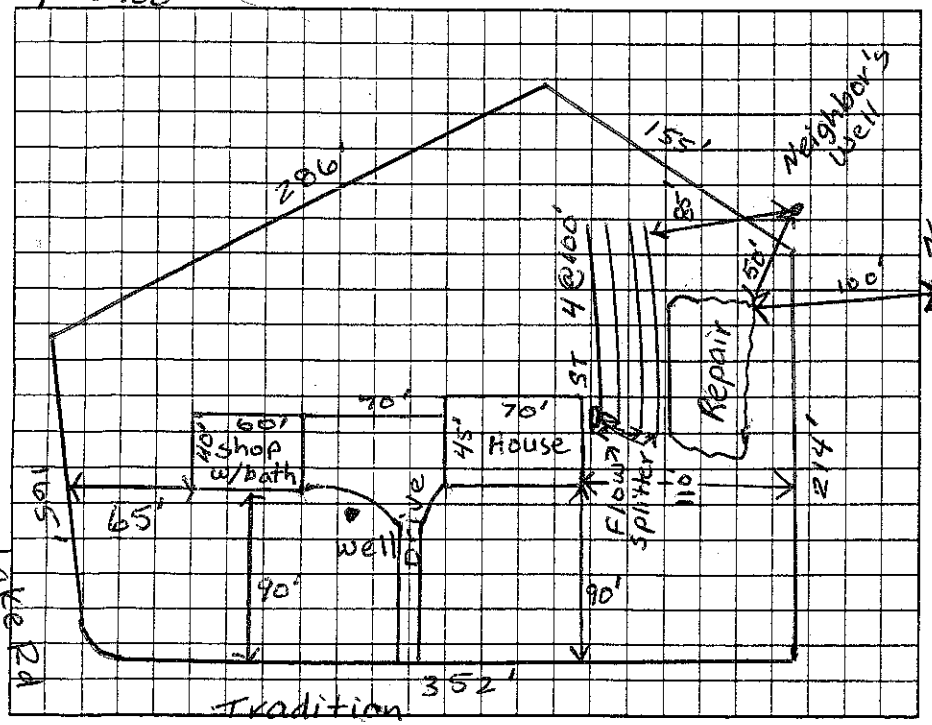

AS BUILT SKETCH

Checked ST & 3 lines of Drainfield Installed Quick 4
6/14/07 4th line checked

Permit can be suspended or revoked if any false information is supplied toward securing the permit/any unauthorized changes are made to the site/any unauthorized changes are made in the installation of the system. Improvement Permit with plat valid without expiration ☐ Improvement Permit with site plan valid for sixty months ☒ Authorization to Construct is valid for a period equal to that of Improvement Permit – not to exceed sixty months.

Signed: [signature] date 11/20/06 Installed by: A&S Grading

Improvement Permit by: Judy Melville date 11-13-06 Operation Permit by: Marie Dolan date 6/14/07

Authorization to Construct by: Judy Melville date 11-15-06 Existing System Inspection by: date

HEALTH DEPT. COPY: WHITE OWNER COPY (FINAL): YELLOW OWNER COPY (INITIAL): PINK