4655454957

IREDELL COUNTY HEALTH DEPARTMENT

STATESVILLE 704-878-5305 MOORESVILLE 704-664-5281

IMPROVEMENT PERMIT / CERTIFICATE OF COMPLETION / OPERATION PERMIT / EXISTING SYSTEM INSPECTION

PROPERTY DESCRIPTION NO. 16657 DATE 7/19/93 TAX MAP NO. ID-7-B-4

OWNER OR CONTRACTOR NEW TREND HOMES PHONE: Business 366-6070 Home

ADDRESS 616 SWEETGUM LN. CHARLOTTE, NC.

LOCATION FAITH RD. ENT. ACROSS FROM MIDWAY LAKE RD.

SUBDIVISION SERENE LAKE BLOCK / SECTION II LOT 4 LOT AREA 114' X 223' SITE CLASS. P L.T.A.R. .3

Water Supply: ☑ Individual ☐ Community ☐ Public

Septic Tank: 1000 Gallons; STB 97 Date 8-2-93

Pump Tank: Gallons; PT Date

Nitrification Field: No Fields 1 Square Feet 1200 Linear Feet 400

No Lines 4 Trench Width 36" Trench Depth 36" Gravel Depth 12"

☑ New System ☐ Repair System Type: I (II) II, IV, V, VI

System Description: CONV. - GRAVITY

Repair System Description: CONV.

Maintenance Agreement Required: ☐ Yes ☑ No

☑ House/Mod. Home No. Bedrooms 3 Garbage Disposal: ☐ Yes ☑ No

☐ Mobile Home No. Bathrooms 2.5 Auto. Dishwasher: ☑ Yes ☐ No


☐ Business No. Employees Auto. Washing Machine: ☑ Yes ☐ No

☐ Other Other

☐ Slab ☑ Crawl Space ☐ Basement w/plumbing ☐ Basement wo/plumbing

Comments

INITIAL SITE SKETCH

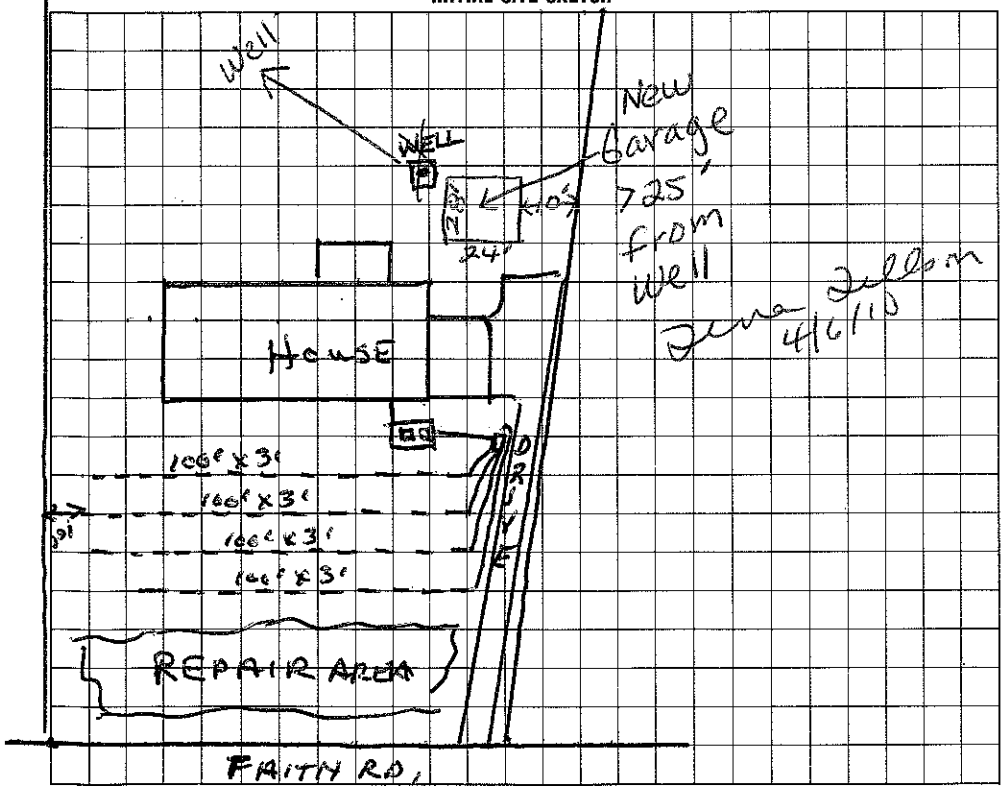

AS BUILT SKETCH

The proposed / ~~existing~~ Garage addition does not appear to impact the existing septic system.

**NOTE:

Andrea Mulvihill REHS

Date: 4-6-10

ICHD-Environmental Health Division

I understand that this permit can be suspended or revoked if any false information is supplied toward securing the permit/any unauthorized changes are made to the site/any unauthorized changes are made in the installation of the system. Improvement Permit is valid for 60 months from date of issuance.

Signed: Carl D. Clark, Jr. Print Name

Improvement Permit by: Wesley Sparks R.S. date 7/19/93

Existing System Inspection by: date

Installed by: LARRY HARWELL

Certificate of Completion by: Wesley Sparks R.S. date 10/18/93

Operation Permit by: date

HEALTH DEPT. COPY: WHITE INSPECTION COPY (FINAL): GREEN OWNER COPY (FINAL): YELLOW INSPECTION COPY (INITIAL): PINK OWNER COPY (INITIAL): GOLD