Authorization to Construct 4655-45-5635

IREDELL COUNTY HEALTH DEPARTMENT

STATESVILLE 704-878-5305 MOORESVILLE 704-664-5281

IMPROVEMENT PERMIT / ~~CERTIFICATE OF COMPLETION~~ / OPERATION PERMIT / EXISTING SYSTEM INSPECTION

PROPERTY DESCRIPTION NO. 16958 DATE 10/31/96 TAX MAP NO. 1 D A 44 Watershed: ☐ Yes ☒ No

OWNER OR CONTRACTOR Dazella Howard PHONE: Business ______ Home 892-1569

ADDRESS 20081 Walter Henderson Rd. Davidson, NC. 28036

LOCATION Faith Rd. 115-21 S TL Faith Rd. in fork of Faith Rd. and Midway Lake Rd.

SUBDIVISION Faith Crossing BLOCK / SECTION ______ LOT 1 LOT AREA .66 Ac SITE CLASS. PS DESIGN FLOW 360 L.T.A.R. .35

Septic Tank: 1000 Gallons; STB 794 Date 7/1/96 ☒ New System ☐ Repair System Type: I, (II), III, IV, V, VI ☒ House/Mod. Home No. Bedrooms 3 Water Supply:

Pump Tank: ______ Gallons; PT ______ Date ______ System Description: DIST BOX – CONV. ☐ Mobile Home No. Bathrooms 3 ☒ Individual

Pump Make: ______ Model ______ Serial No. ______ Repair System Description: SAME ☐ Business No. Employees ______ ☐ Community


Nitrification Field: No Fields 1 Square Feet 1028 Linear Feet 345 Maintenance Agreement Required: ☐ Yes ☒ No ☐ Other ______ ☐ Public

No Lines 3 Trench Width 36" Max Trench Bottom Depth 36" Gravel Depth 12" ☐ Slab ☒ Crawl Space ☐ Basement w/plumbing ☐ Basement wo/plumbing

Comments: Change from 9/4/93 Permit

Comments:

INITIAL SITE SKETCH

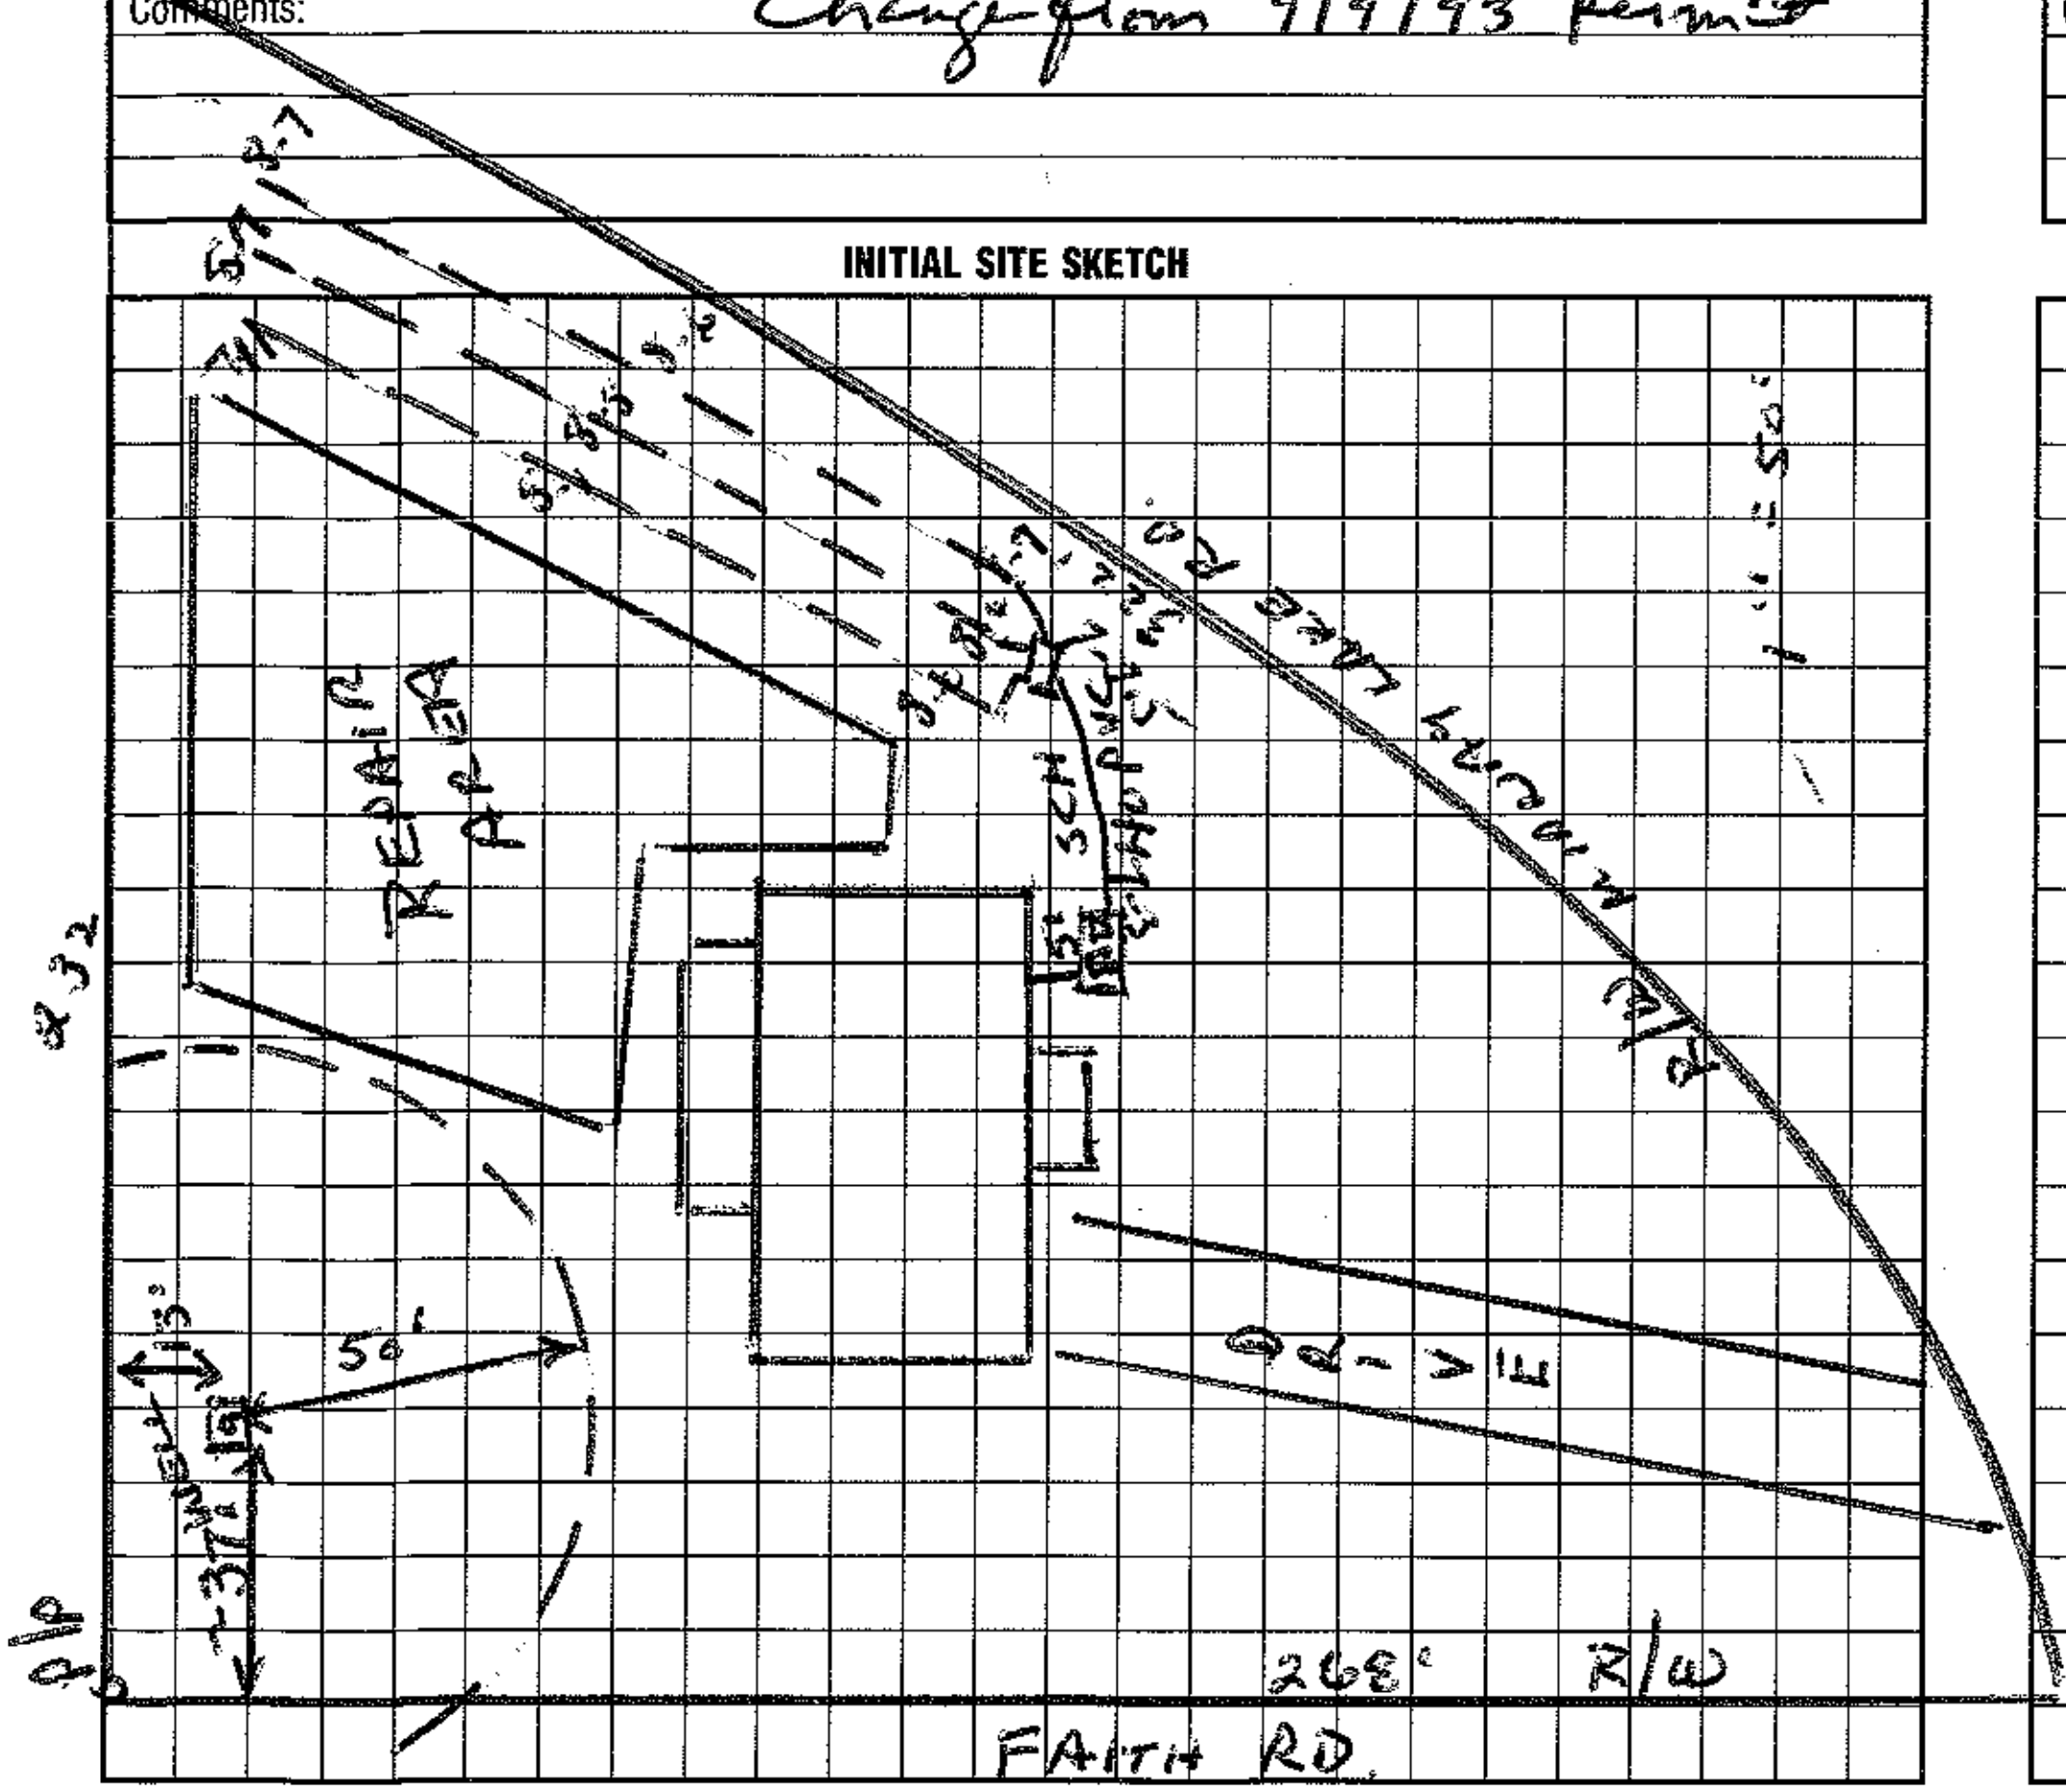

AS BUILT SKETCH

I understand that this permit can be suspended or revoked if any false information is supplied toward securing the permit/any unauthorized changes are made to the site/any unauthorized changes are made in the installation of the system.

Signed: X Vera Robertson

Installed by: A Cornelius Grading

Improvement Permit by: Wesley Sparks R.S. date 10/31/96

Certificate of Completion by: ______ date ______

~~Existing System Inspection by:~~ Auth. To Construct Wesley Sparks RS date 10/31/96

Operation Permit by: Wesley Sparks R.S. date 11/14/96

HEALTH DEPT. COPY: WHITE INSPECTION COPY (FINAL): GREEN OWNER COPY (FINAL): YELLOW INSPECTION COPY (INITIAL): PINK OWNER COPY (INITIAL): GOLD