IREDELL COUNTY HEALTH DEPARTMENT

STATESVILLE 704-878-5305 MOORESVILLE 704-664-5281

IMPROVEMENT PERMIT / AUTHORIZATION TO CONSTRUCT / OPERATION PERMIT / EXISTING SYSTEM INSPECTION

11:30

PERMIT# 090738 PIN# 4655455971 Builder Jim Morgan (336)917-8557 DATE 8-3-2000

OWNER OR CONTRACTOR Edward Hicks PHONE: Business 417-2728 Home 568-1336

ADDRESS 5902 Monroe Rd. Apt. B2 Charlotte, NC 28212

LOCATION Hwy 115 South TL Faith Rd 3rd lot past Jennie Marie on left

SUBDIVISION Serene Lake BLOCK / SECTION II LOT 3 LOT AREA .70 Acre SITE CLASS. RS DESIGN FLOW 360gpd L.T.A.R. .3

Septic Tank: 1000 Gallons; STB 794 Date 11-14-00
Pump Tank: ____ Gallons; PT ____ Date ____
Pump Make: ____ Model ____ Serial No. ____
Nitrification Field: No Fields 1 Square Feet 1200' Linear Feet 400'
No Lines 4 at 100 Trench Width 36" Max Trench Bottom Depth 24"-30" Gravel Depth 12"

☒ New System ☐ Repair System Type: I, II, III, IV, V, VI
System Description: Gravity - Conventional
Repair System Description: Innovative
Maintenance Agreement Required: ☐ Yes ☒ No


☒ House/Mod. Home ☐ Mobile Home ☐ Business ☐ Other
No. Bedrooms 3 No. Bathrooms 2 No. Employees ____
☐ Slab ☒ Crawl Space ☐ Basement w/plumbing ☐ Basement wo/plumbing

Water Supply: ☒ Individual ☐ Public ☐ Community


Comments/Conditions: Keep Septic System at least 10' from PL & 5' from house, and at least 50' from any well

Comments/Conditions: Do Not Grade House location, so gravity flow can be maintained. Riser installed & Polylok installed

INITIAL SITE SKETCH Scale 1:40'

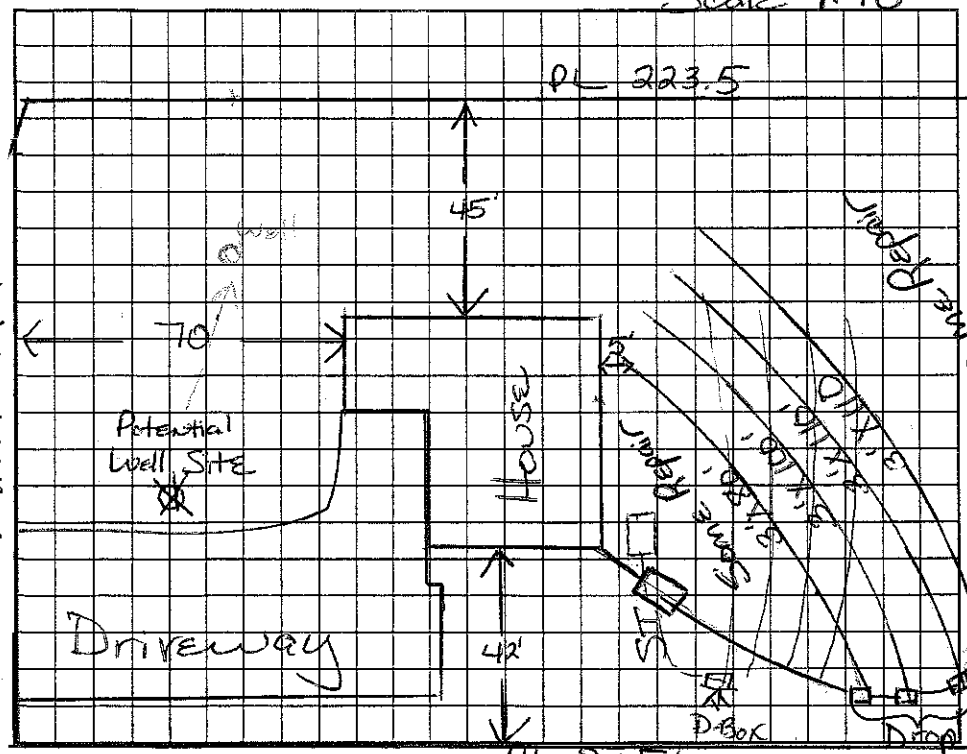

AS BUILT SKETCH

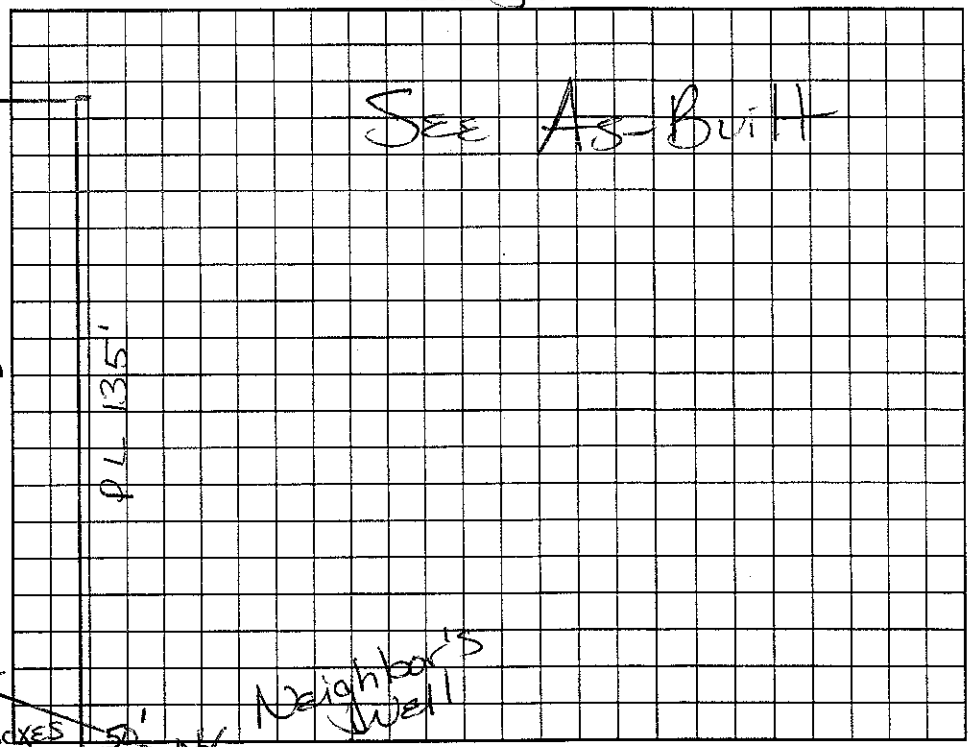

Permit can be suspended or revoked if any false information is supplied toward securing the permit/any unauthorized changes are made to the site/any unauthorized changes are made in the installation of the system. Improvement Permit with plat valid without expiration. Improvement Permit with site plan valid for sixty months. Authorization to Construct is valid for a period equal to that of Improvement Permit – not to exceed sixty months.

Signed: X Edward F. Hicks date 8-4-00

Improvement Permit by: Maria H. Watson RS date 8/3/2000

Authorization to Construct by: Maria H. Watson RS date 8/3/2000

Installed by: F J Ervin

Operation Permit by: Maria H. Watson RS date 2/6/2001

Existing System Inspection by: ____ date ____

HEALTH DEPT. COPY: WHITE OWNER COPY (FINAL): YELLOW OWNER COPY (INITIAL): PINK

IREDELL COUNTY HEALTH DEPARTMENT

STATESVILLE 704-878-5305 MOORESVILLE 704-664-5281

IMPROVEMENT PERMIT / AUTHORIZATION TO CONSTRUCT / OPERATION PERMIT / EXISTING SYSTEM INSPECTION

PERMIT# 096738 PIN# 4655455971 DATE 2/7/2001

OWNER OR CONTRACTOR Edward Hicks PHONE: Business 417-2728 Home 568-1331

ADDRESS 5902 Monroe Rd Apt B2 Charlotte, NC 28212

LOCATION

SUBDIVISION Serene Lake BLOCK / SECTION II LOT 3 LOT AREA .70 Acre SITE CLASS. PS DESIGN FLOW 360gpd L.T.A.R. .3

Septic Tank: 1000 Gallons; STB 794 Date 11-14-00
Pump Tank: Gallons; PT Date
Pump Make: Model Serial No.
Nitrification Field: No Fields 1 Square Feet 1200' Linear Feet 400'
No Lines 4 at 100' Trench Width 36" Max Trench Bottom Depth 24-30 Gravel Depth 12"

☒ New System ☐ Repair System Type: I, II, III, IV, V, VI
System Description: Gravity - Conventional
Repair System Description: Innovative
Maintenance Agreement Required: ☐ Yes ☒ No


☒ House/Mod. Home No. Bedrooms 3
☐ Mobile Home No. Bathrooms 2
☐ Business No. Employees
☐ Other
☐ Slab ☒ Crawl Space ☐ Basement w/plumbing ☐ Basement wo/plumbing

Water Supply: ☒ Individual ☐ Public ☐ Community


Comments:/Conditions:

Comments:/Conditions:

INITIAL SITE SKETCH

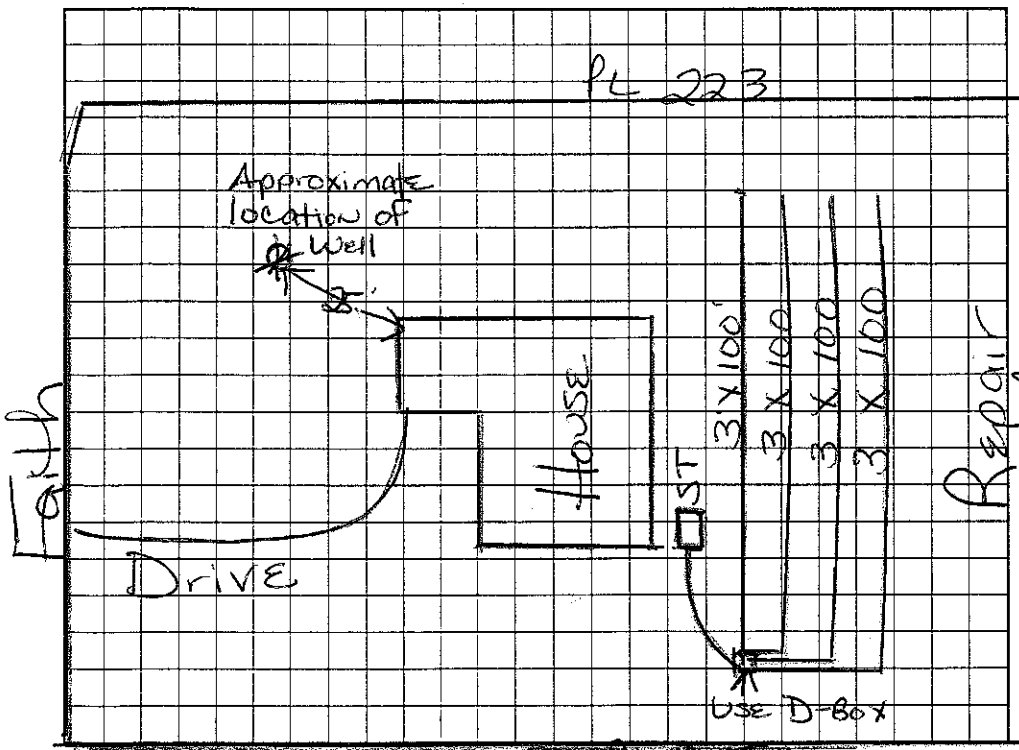

AS BUILT SKETCH

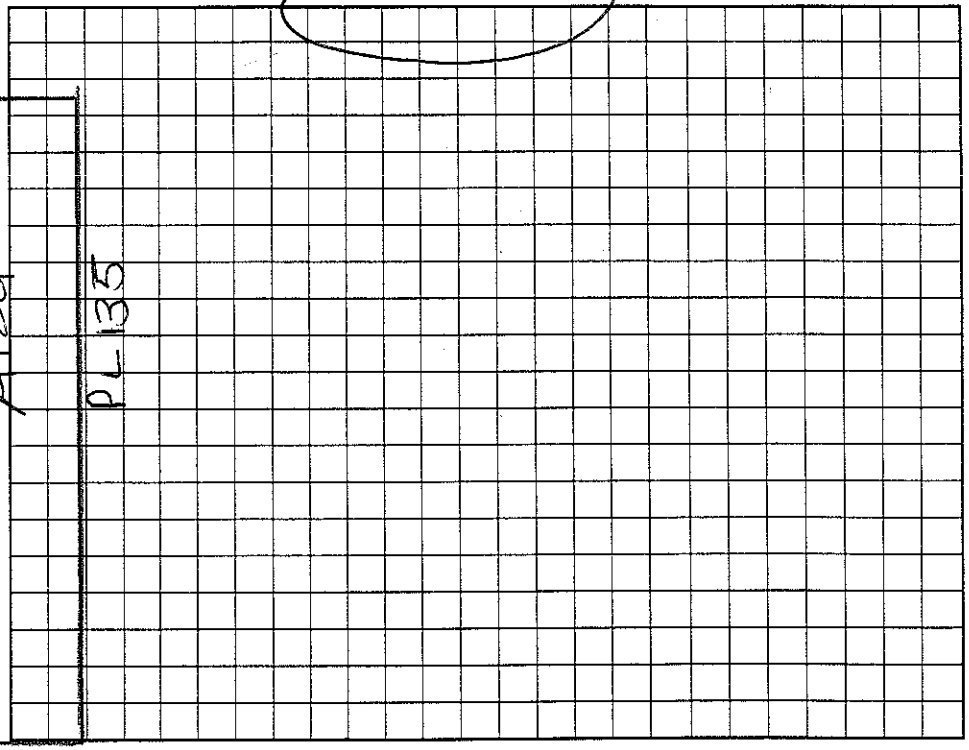

Permit can be suspended or revoked if any false information is supplied toward securing the permit/any unauthorized changes are made to the site/any unauthorized changes are made in the installation of the system. Improvement Permit with plat valid without expiration. Improvement Permit with site plan valid for sixty months. Authorization to Construct is valid for a period equal to that of Improvement Permit – not to exceed sixty months.

Signed: date

Improvement Permit by: date

Authorization to Construct by: date

Installed by: FJ Ervin

Operation Permit by: Maria H. Dotson RS date 2/7/2001

Existing System Inspection by: date

HEALTH DEPT. COPY: WHITE OWNER COPY (FINAL): YELLOW OWNER COPY (INITIAL): PINK