IREDELL COUNTY HEALTH DEPARTMENT

STATESVILLE 704-878-5305 MOORESVILLE 704-664-5281

IMPROVEMENT PERMIT / ~~CERTIFICATE~~ OF COMPLETION / OPERATION PERMIT / EXISTING SYSTEM INSPECTION

PROPERTY DESCRIPTION NO. 20218 DATE 2/23/95 TAX MAP NO. ~~2F 10A 120~~ 4655-45-7805 Watershed: ☐ Yes ☐ No

OWNER OR CONTRACTOR D+D Homes PHONE: Business 568-8711 Home

ADDRESS 6101 Idlewild #209 Charlotte, NC. 28212

LOCATION Forks Rd from Charlotte Hwy past Serene Lake Dr.

SUBDIVISION Serene Lake BLOCK / SECTION ~~2~~ LOT 2/120 LOT AREA ± 1.75Ac SITE CLASS. P DESIGN FLOW 360 L.T.A.R. .3-.35

Septic Tank: 1000 Gallons; STB 714 Village Date 5-8-95

Pump Tank: ____ Gallons; PT ____ Date ____

Pump Make: ____ Model ____ Serial No. ____

Nitrification Field: No Fields 1 Square Feet 1028 Linear Feet 345

No Lines 4 Trench Width 36" Max Trench Bottom Depth 32" Gravel Depth 12"

☑ New System ☐ Repair System Type: I, ☑ II, III, IV, V, VI

System Description: conv.

Repair System Description: 16" PPBS

Maintenance Agreement Required: ☐ Yes ☑ No

☑ House/Mod. Home No. Bedrooms 3

☐ Mobile Home No. Bathrooms 2

☐ Business No. Employees ____

☐ Other ____


☐ Slab ☑ Crawl Space ☐ Basement w/plumbing ☐ Basement wo/plumbing

Water Supply: ☑ Individual ☐ Community ☐ Public


Comments: Follow contours in manner shown. Shallow -

Comments:

INITIAL SITE SKETCH

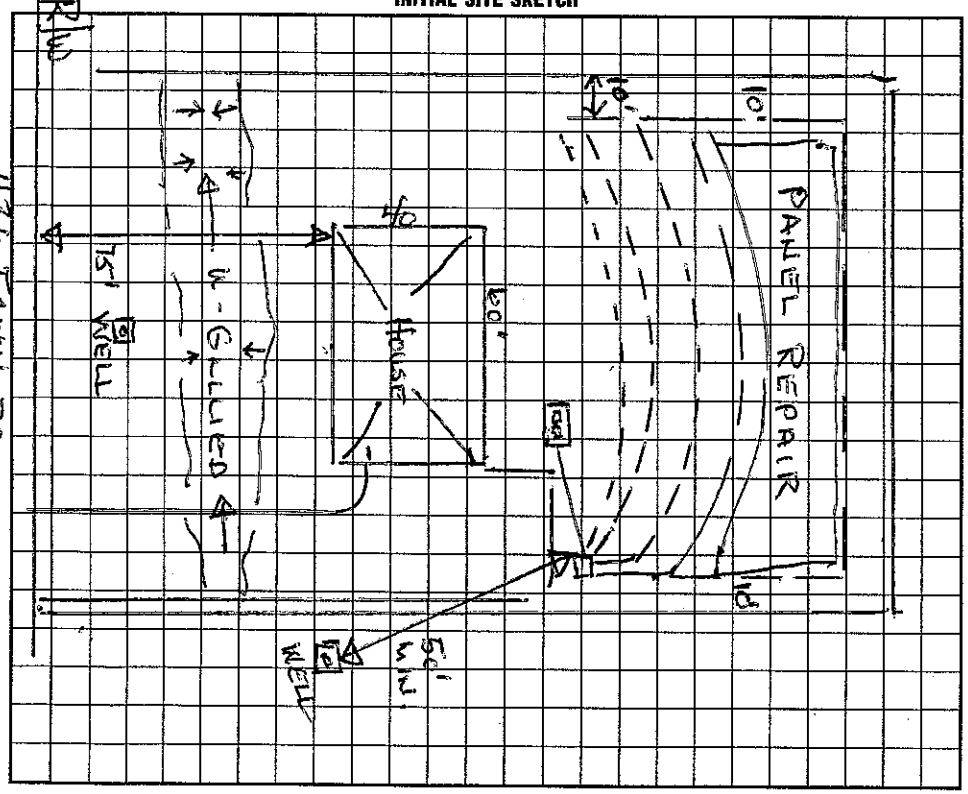

AS BUILT SKETCH

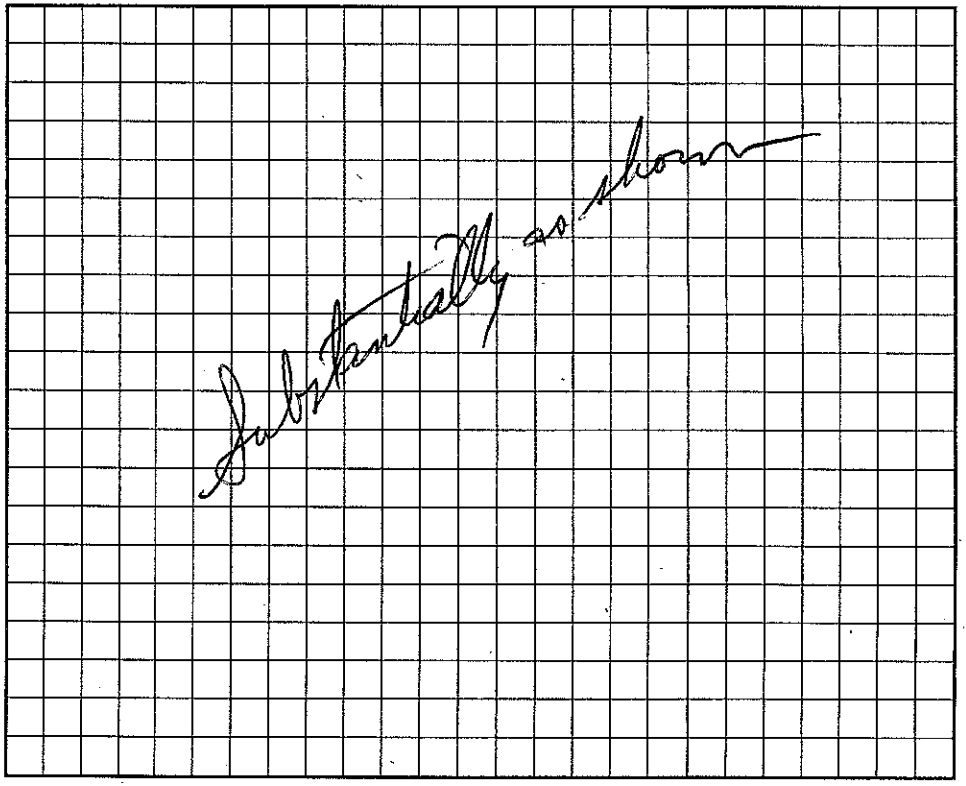

I understand that this permit can be suspended or revoked if any false information is supplied toward securing the permit/any unauthorized changes are made to the site/any unauthorized changes are made in the installation of the system. Improvement Permit is valid for 60 months from date of issuance.

Signed: ____

Improvement Permit by: Wesley Sparks RS. date 2/23/95

Existing System Inspection by: ____ date ____

Installed by: A. Capelous Grading

Certificate of Completion by: DK Hussey RS date 7-13-95

Operation Permit by: ____ date ____

HEALTH DEPT. COPY: WHITE INSPECTION COPY (FINAL): GREEN OWNER COPY (FINAL): YELLOW INSPECTION COPY (INITIAL): PINK OWNER COPY (INITIAL): GOLD