IREDELL COUNTY HEALTH DEPARTMENT

STATESVILLE 704-878-5305 MOORESVILLE 704-664-5281

IMPROVEMENT PERMIT / CERTIFICATE OF COMPLETION / OPERATION PERMIT / EXISTING SYSTEM INSPECTION

PROPERTY DESCRIPTION NO. 20218 DATE 2/23/95 TAX MAP NO. ~~2T 10A 120~~ 4655-45-7805 Watershed: ☐ Yes ☐ No

OWNER OR CONTRACTOR D+D Homes PHONE: Business 568-8711 Home

ADDRESS 6101 Idlewild #209 Charlotte, NC. 28212

LOCATION Faith Rd from Charlotte Hwy past Serene Lake Dr.

SUBDIVISION Serene Lake BLOCK / SECTION ~~Phase~~ LOT 2/120 LOT AREA ~.75Ac SITE CLASS. P DESIGN FLOW 360 L.T.A.R. .3-.35

Septic Tank: 1000 Gallons; STB PH Dillaway Date 5-18-95
Pump Tank: ____ Gallons; PT ____ Date ____
Pump Make: ____ Model ____ Serial No. ____
Nitrification Field: No Fields 1 Square Feet 1028 Linear Feet 345
No Lines 4 Trench Width 36" Max Trench Bottom Depth 32" Gravel Depth 12"

☑ New System ☐ Repair System Type: I, ☑ II, III, IV, V, VI
System Description: Conv.
Repair System Description: 1601 PPBS
Maintenance Agreement Required: ☐ Yes ☑ No

☑ House/Mod. Home No. Bedrooms 3
☐ Mobile Home No. Bathrooms 2
☐ Business No. Employees ____
☐ Other ____


☐ Slab ☑ Crawl Space ☐ Basement w/plumbing ☐ Basement wo/plumbing

Water Supply:
☑ Individual
☐ Community
☐ Public

Comments: Follow contours in manner shown. Shallow -


Comments:

INITIAL SITE SKETCH

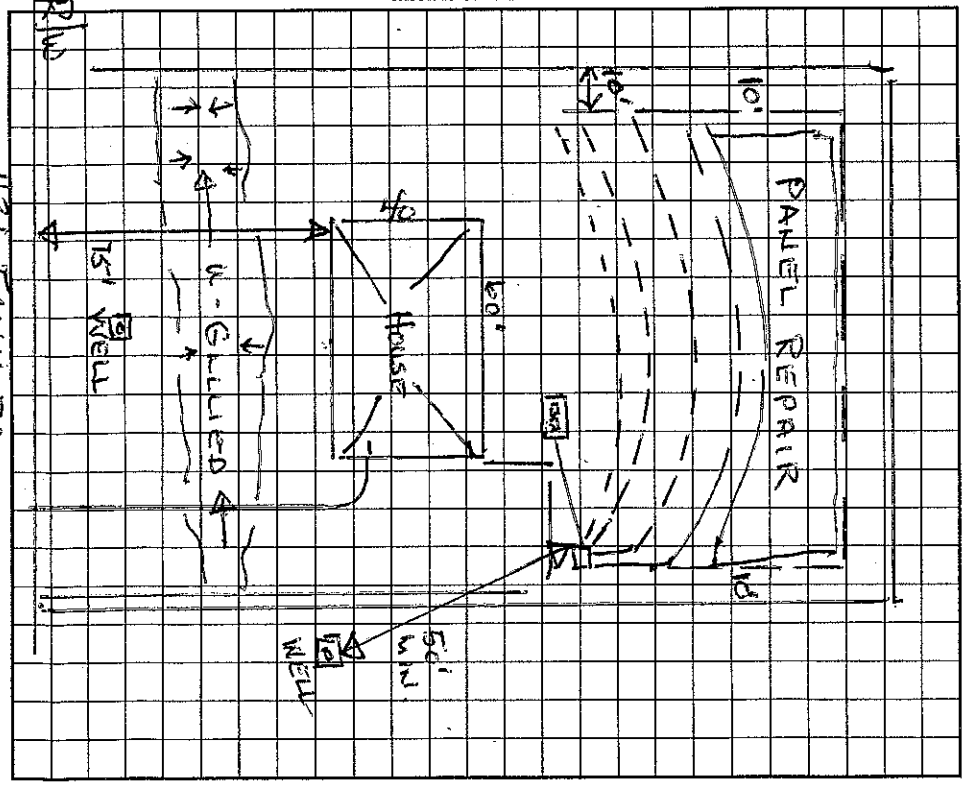

11336 Faith Rd.

AS BUILT SKETCH

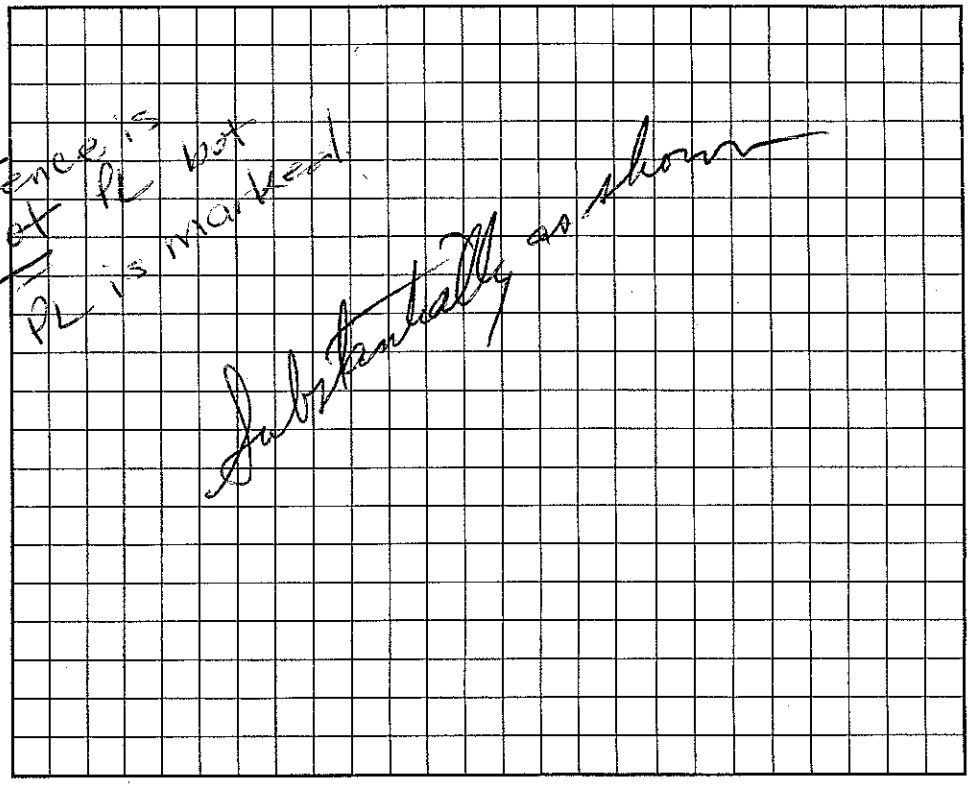

I understand that this permit can be suspended or revoked if any false information is supplied toward securing the permit/any unauthorized changes are made to the site/any unauthorized changes are made in the installation of the system. Improvement Permit is valid for 60 months from date of issuance.

Signed: ____

Improvement Permit by: Wesley Sparks R.S. date 2/23/95

Existing System Inspection by: ____ date ____

Installed by: A. Cornelius Grading

Certificate of Completion by: D. Hussey R.S. date 7-3-95

Operation Permit by: ____ date ____

HEALTH DEPT. COPY: WHITE INSPECTION COPY (FINAL): GREEN OWNER COPY (FINAL): YELLOW INSPECTION COPY (INITIAL): PINK OWNER COPY (INITIAL): GOLD