IREDELL COUNTY HEALTH DEPARTMENT

STATESVILLE 704-878-5305 | MOORESVILLE 704-664-5281

4655458748

IMPROVEMENT PERMIT / CERTIFICATE OF COMPLETION / OPERATION PERMIT / EXISTING SYSTEM INSPECTION

PROPERTY DESCRIPTION NO. 18902 DATE 8/18/94 TAX MAP NO. ID-7-B-1 Watershed: ☐ Yes ☑ No

OWNER OR CONTRACTOR Christopher Conley PHONE: Business _____ Home 548-8356

ADDRESS 3201-A Pier Point Dr. Char. 28269

LOCATION Faith Rd on (L) before Mott Rd, just past Midway Lake on (R)

SUBDIVISION Seven Lake BLOCK / SECTION _____ LOT 1 LOT AREA .7 AC SITE CLASS. P DESIGN FLOW 360 L.T.A.R. .3-.35

Septic Tank: ~~1250~~ 1500 Gallons; STB 797 Date 7/23/94

Pump Tank: _____ Gallons; PT _____ Date _____

Pump Make: _____ Model _____ Serial No. _____

Nitrification Field: No Fields 1 Square Feet 1028 Linear Feet 342

No Lines 5 Trench Width _____ Max Trench Bottom Depth _____ Gravel Depth _____

☑ New System ☐ Repair System Type: I, (II), III, IV, V, VI

System Description: CONV - DROP BOX

Repair System Description: _____

Maintenance Agreement Required: ☐ Yes ☑ No

☑ House/Mod. Home No. Bedrooms 3

☐ Mobile Home No. Bathrooms 2

☐ Business No. Employees _____

☐ Other _____


☐ Slab ☑ Crawl Space ☐ Basement w/plumbing ☐ Basement wo/plumbing

Water Supply: ☑ Individual ☐ Community ☐ Public


Comments: 1250 due to garbage disposal

Comments:

INITIAL SKETCH

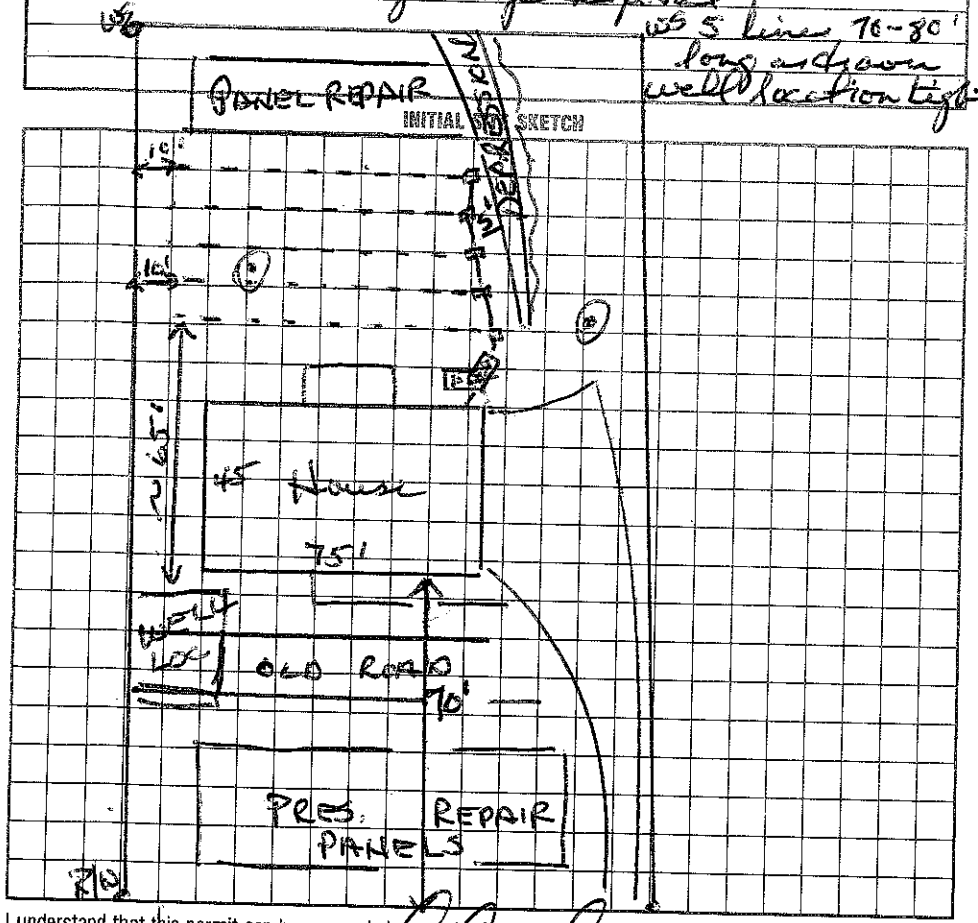

AS BUILT SKETCH

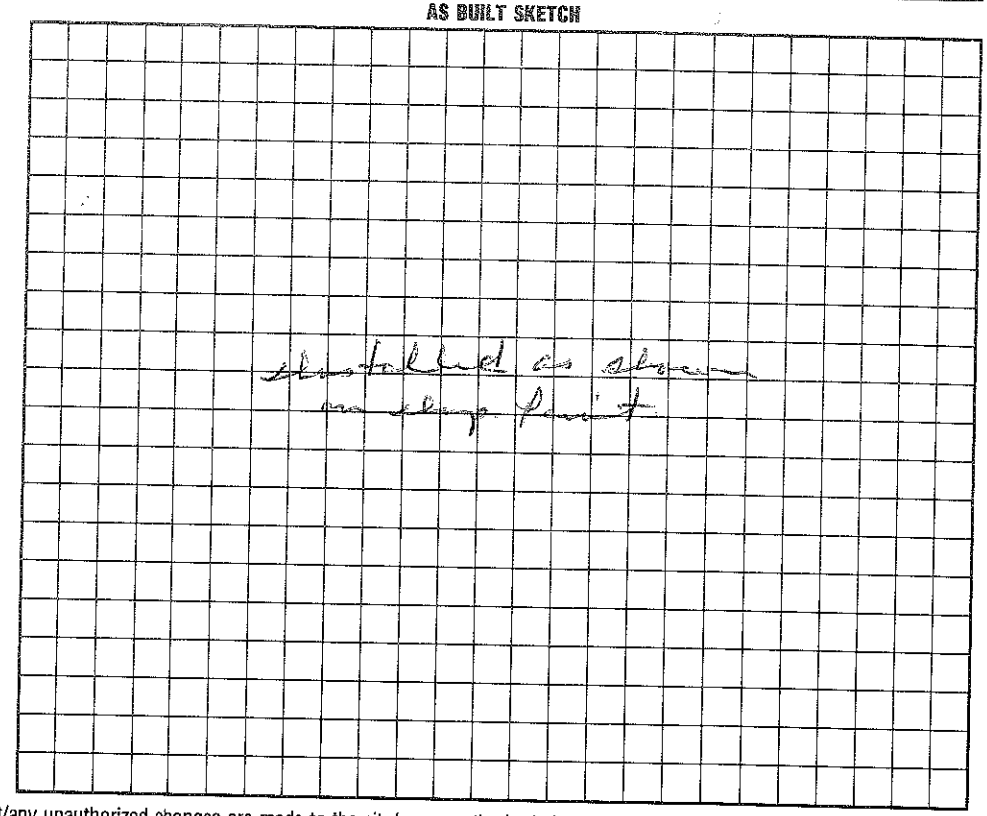

I understand that this permit can be suspended or revoked if any false information is supplied toward securing the permit/any unauthorized changes are made to the site/any unauthorized changes are made in the installation of the system. Improvement Permit is valid for 60 months from date of issuance.

Signed: + Faith Rd

Improvement Permit by: Wesley Sparks RS date 8/18/94

Existing System Inspection by: _____ date _____

Installed by: R L Mackie & Company Co.

Certificate of Completion by: Wesley Sparks RS date 11/30/94

Operation Permit by: _____ date _____

HEALTH DEPT. COPY: WHITE | INSPECTION COPY (FINAL): GREEN | OWNER COPY (FINAL): YELLOW | INSPECTION COPY (INITIAL): PINK | OWNER COPY (INITIAL): GOLD