IREDELL COUNTY HEALTH DEPARTMENT

STATESVILLE 704-878-5305 80.00 Paid MOORESVILLE 704-664-5281 12.00

IMPROVEMENT PERMIT / AUTHORIZATION TO CONSTRUCT / OPERATION PERMIT / EXISTING SYSTEM INSPECTION

PERMIT# 109259 PIN# 4655 46 4955 DATE 11/7/02

OWNER OR CONTRACTOR John + Patricia Bunch PHONE: Business Home 704-660-7009

ADDRESS 106 Kipling Ln. Mooresville, NC. 28115

LOCATION 1155 TL to Faith Rd TL Jenny Marie TR Hendwick Place, 1st 2 lots on (R)

SUBDIVISION Serene Lake BLOCK / SECTION LOT 16+17 LOT AREA ~1.7 AC SITE CLASS. PS DESIGN FLOW 480 L.T.A.R. .2

Septic Tank: 1000 Gallons: STB 1914 Date 4-14-03

Pump Tank: 1000 Gallons: PT 27 Date 4-15-03

Pump Make: Southern Model BOND WE05111H Serial No.

Nitrification Field: No Fields 1 Square Feet 1800 Linear Feet 600

No Lines 6@90 Trench Width 3' Max Trench Bottom Depth 30"

[X] New System [ ] Repair System Type: I, II, III, IV, V, VI

System Description: Pres. Man. → INNOVATIVE

Repair System Description: SAME

Maintenance Agreement Required: [ ] Yes [X] No

Gravel Depth No

[X] House/Mod. Home No. Bedrooms 4

[ ] Mobile Home No. Bathrooms 3

[ ] Business No. Employees

[ ] Other


[ ] Slab [ ] Crawl Space [X] Basement w/plumbing [ ] Basement wo/plumbing

Water Supply: [X] Individual [ ] Public [ ] Community

Comments/Conditions:

Comments/Conditions: Checked tanks & upper 3 lines 5/22/03 MD

INITIAL SITE SKETCH

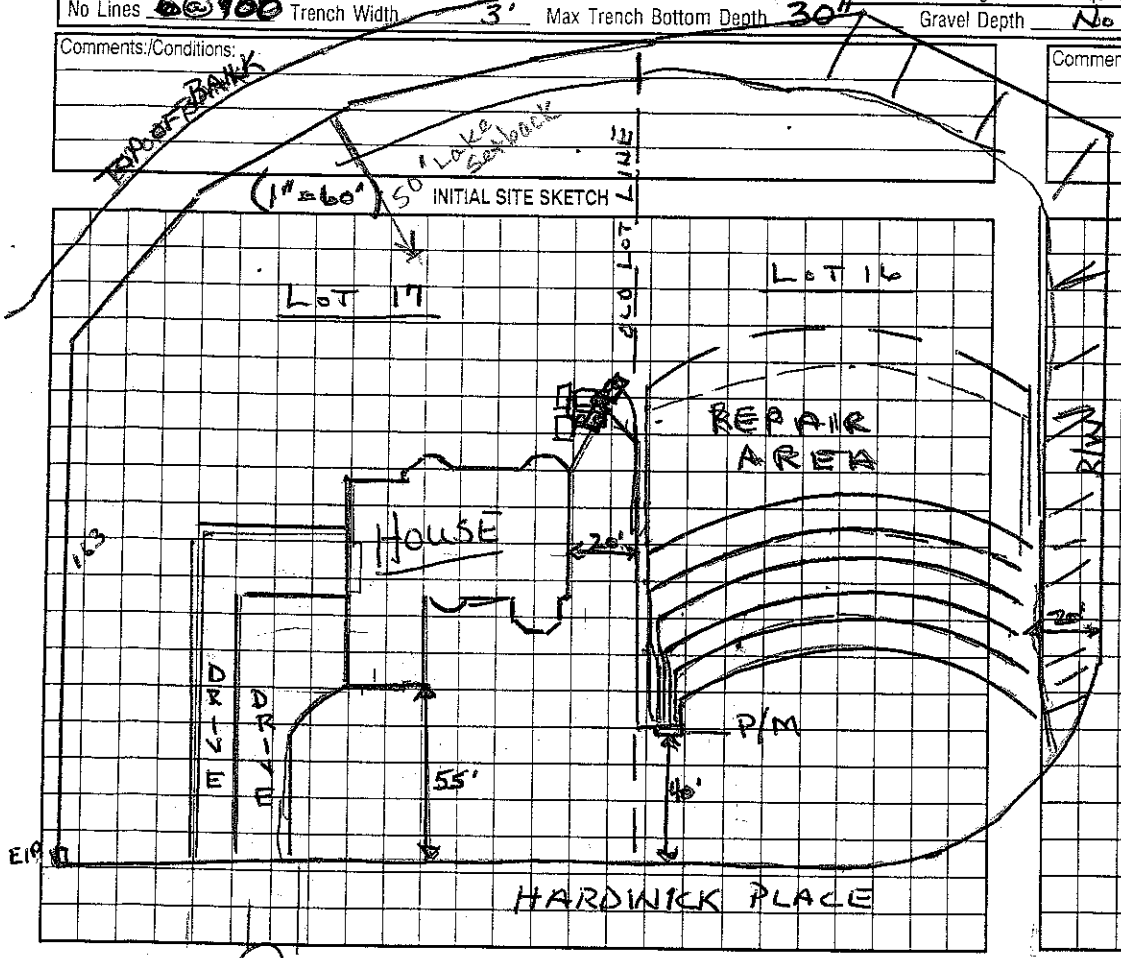

AS BUILT SKETCH

Installed "Plastic Chamber" Drainfield.

This system approved for 4 BDRMS. Total 6/27/03 AWS

Permit can be suspended or revoked if any false information is supplied toward securing the permit/any unauthorized changes are made to the site/any unauthorized changes are made in the installation of the system. Improvement Permit with plat valid without expiration. Improvement Permit with site plan valid for sixty months. Authorization to Construct is valid for a period equal to that of Improvement Permit – not to exceed sixty months.

Signed: * date 11-7-02 Installed by: F.J. Ervin

Improvement Permit by: Wesley Sparks RS. date 11/7/02 Operation Permit by: Wesley Sparks RS. date 6/27/03

Authorization to Construct by: Wesley Sparks RS date 11/7/02 Existing System Inspection by: date

HEALTH DEPT. COPY: WHITE OWNER COPY (FINAL): YELLOW OWNER COPY (INITIAL): PINK