IREDELL COUNTY HEALTH DEPARTMENT

STATESVILLE 704-878-5305 4655 465577 MOORESVILLE 704-664-5281

IMPROVEMENT PERMIT / CERTIFICATE OF COMPLETION / OPERATION PERMIT / EXISTING SYSTEM INSPECTION

PROPERTY DESCRIPTION NO. 15043 DATE 3/30/94 TAX MAP NO. 10 7 B 12

OWNER OR CONTRACTOR Mike Kacenga PHONE: Business Watershed: ☐ Yes ☐ No

ADDRESS 21108 Pine Ridge Dr. Cornelius, NC. 28031 Home 892-7373

LOCATION Lot 12 Jarvis Wood Ct.

SUBDIVISION CRYSTAL/SERENE BLOCK / SECTION LOT 12 LOT AREA SITE CLASS. P DESIGN FLOW 360 L.T.A.R. .3

Septic Tank: 1000 Gallons; STB 794 Date 8/29/95

Pump Tank: Gallons; PT Date

Pump Make: Model Serial No.

Nitrification Field: No Fields 1 Square Feet 1200 Linear Feet 400

No Lines 4 Trench Width 3' Max Trench Bottom Depth 32" Gravel Depth 12"

☑ New System ☐ Repair System Type: I II III IV V VI

System Description: CONV - DROP BOX

Repair System Description:

Maintenance Agreement Required: ☐ Yes ☑ No

☑ House/Mod. Home ☐ Mobile Home ☐ Business ☐ Other

No. Bedrooms 3 No. Bathrooms 3.5 No. Employees


Water Supply: ☑ Individual ☐ Community ☐ Public

☐ Slab ☐ Crawl Space ☐ Basement w/plumbing ☐ Basement wo/plumbing

Comments:

Comments: 300 FT drop Box trench Tractor

INITIAL SITE SKETCH

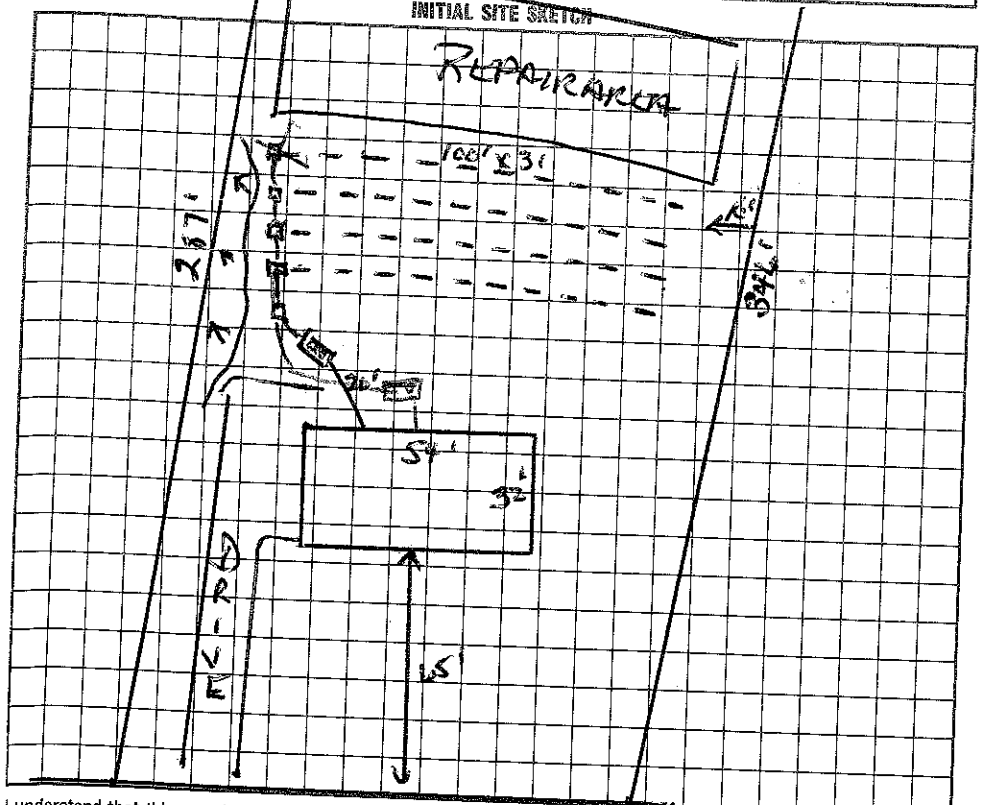

AS BUILT SKETCH

I understand that this permit can be suspended or revoked if any false information is supplied toward securing the permit/any unauthorized changes are made to the site/any unauthorized changes are made in the installation of the system. Improvement Permit is valid for 60 months from date of issuance.

Signed: JAMES WILBERT, Jr. Mike Kacenga

Improvement Permit by: Wesley Sparks R.S. date 3/31/94

Existing System Inspection by: date

Installed by: Bob Mayhew

Certificate of Completion by: Wesley Sparks R.S. date 11/22/95

Operation Permit by: Wesley Sparks R.S. date 11/22/95

HEALTH DEPT. COPY: WHITE INSPECTION COPY (FINAL): GREEN OWNER COPY (FINAL): YELLOW INSPECTION COPY (INITIAL): PINK OWNER COPY (INITIAL): GOLD