IREDELL COUNTY HEALTH DEPARTMENT - *ENVIRONMENTAL HEALTH* ☐ STATESVILLE OFFICE 704-878-5305 ☒ MOORESVILLE OFFICE 704-664-5281

IMPROVEMENT PERMIT / AUTHORIZATION TO CONSTRUCT / OPERATION PERMIT / EXISTING SYSTEM INSPECTION

PERMIT # 168915 PIN # 4655-46-6192 DATE 10-25-11

OWNER GRANDE HOMES APPLICANT: SAME PHONE: Home/Cell # 764-400-1710 Business #

SITE ADDRESS 152 JAMI WINDSET MVILLE. OWNER / APPLICANT ADDRESS 555 DELBURG ST. DAVIDSON

SITE DIRECTIONS FAITH RD, JENNY MARIE, TR JAMI WIND, ON R

SUBDIVISION SERENE LAKE BLOCK / SECTION II LOT # 6 LOT AREA DESIGN FLOW 480 L.T.A.R. .5

Septic Tank 1000 Gallons: STB 799 Date 11-8-11

Pump Tank Gallons: P T Date

Pump Make Model Serial #

No. Nitrification Fields: 1 No. Lines 5 Linear Feet 300'

Trench Width 36" Max. Trench Bottom Depth 36" Gravel Depth —

☒ New System ☐ Repair ☐ Expansion System Type I II (III) IV V VI

System Description: 25% REDUCTION

Repair System Description: PM - 25%

Maintenance Agreement Required ☐ YES ☒ NO

☒ GRAVITY ☐ PRESSURE

☒ Residence No. Bedrooms 4

☐ Business No. Persons

☐ Other No. Employees


☐ Slab ☒ Crawl Space

☐ Basement w/plumbing ☐ Basement w/o plumbing


Water Supply: ☒ Private ☐ Public ☐ Community

Comments / Conditions (1) HOUSE SHOULD BE ~55' FROM FRONT PROP. LINE (2) FOLLOW STATE RULES

INITIAL SITE SKETCH

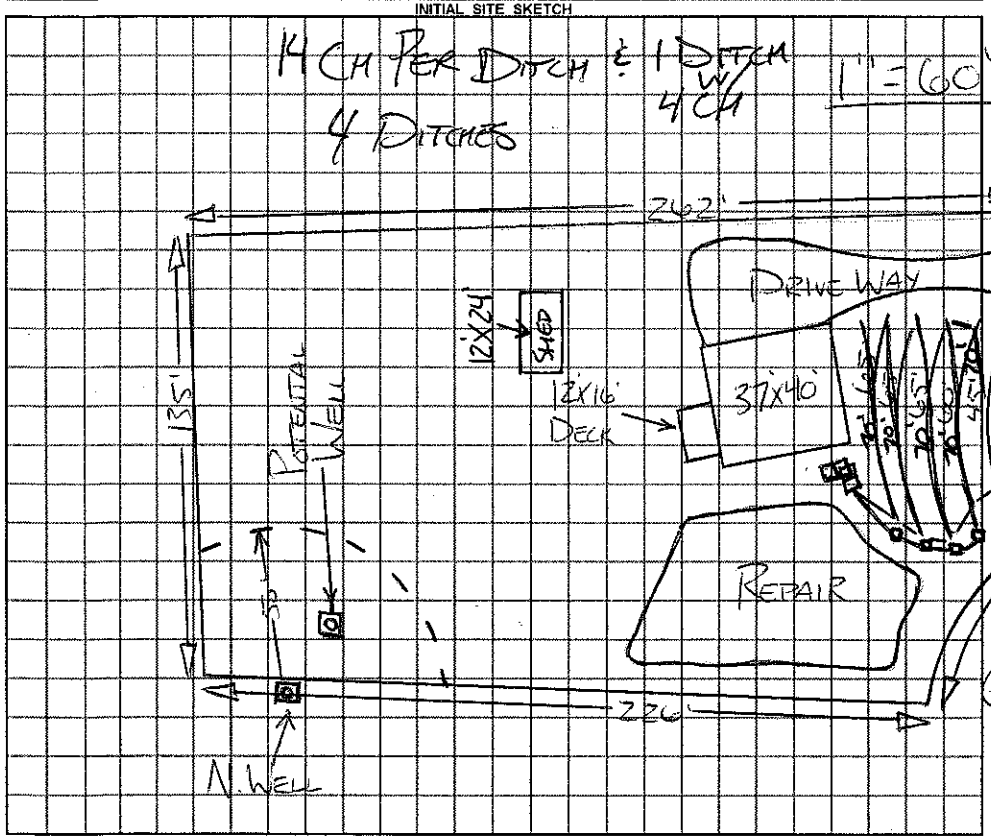

AS BUILT SKETCH

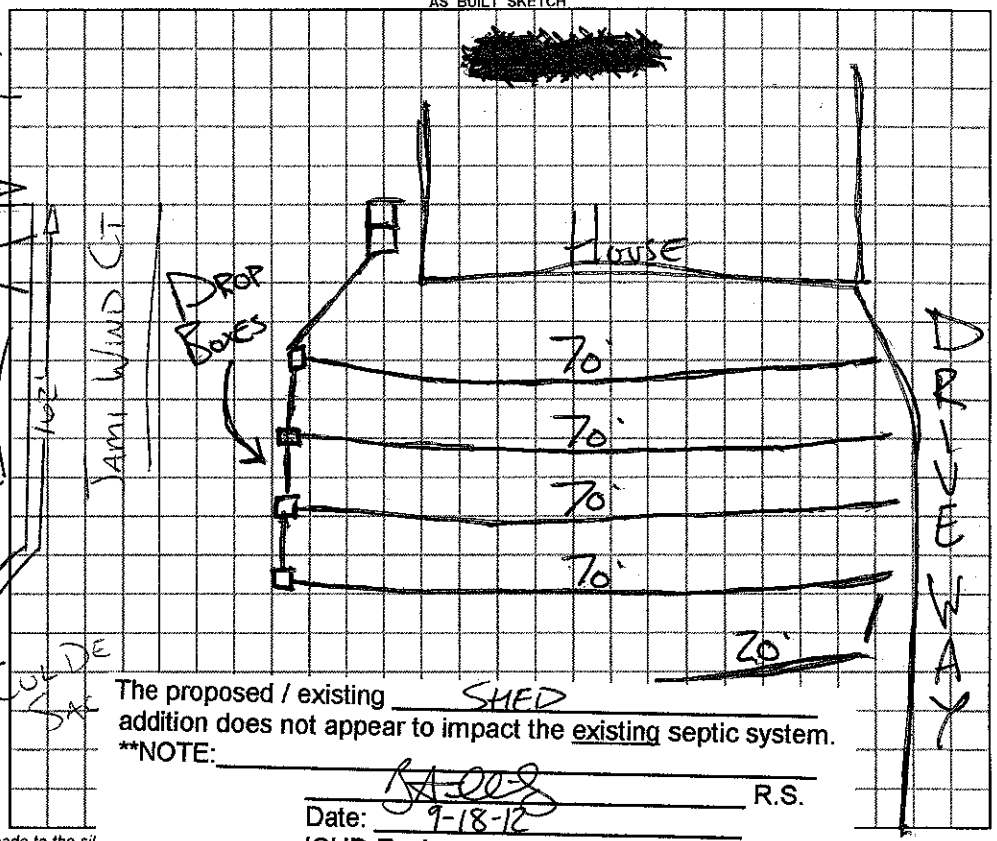

The proposed / existing SHED addition does not appear to impact the existing septic system.

**NOTE:

R.S.

Date: 9-18-12

ICHD-Environmental Health Division

Permit can be suspended or revoked if any false information is supplied toward securing the permit / any unauthorized changes are made to the sil

☐ *IMPROVEMENT PERMIT* with plat valid without expiration. ☐ *IMPROVEMENT PERMIT* with ~~plat valid without expiration.~~ site plan valid 60 mo. ☑ AUTHORIZATION TO CONSTRUCT to exceed 60 mo.

Owner / Applicant Signature: Date 10-26-11 Installed by: CHRISTENBURY

IMPROVEMENT PERMIT by: REHS Date 10-26-11 OPERATION PERMIT by: REHS Date 1-18-12

AUTHORIZATION TO CONSTRUCT by: REHS Date 10-26-11 Existing System Inspected by: REHS Date

YOU SHOULD CONTACT A LOCATOR SERVICE PRIOR TO ANY EXCAVATION

White Copy – Environmental Health YELLOW COPY (Final) Owner / Applicant PINK COPY (Initial) Owner / Applicant