IREDELL COUNTY HEALTH DEPARTMENT

STATESVILLE 704-878-5305 MOORESVILLE 704-664-5281

4655468031

IMPROVEMENT PERMIT / CERTIFICATE OF COMPLETION / OPERATION PERMIT / EXISTING SYSTEM INSPECTION

PROPERTY DESCRIPTION NO. 19383 DATE 9/27/94 TAX MAP NO. 10-7-B-7 Watershed: ☐ Yes ☒ No

OWNER OR CONTRACTOR Elvis Hendricks BOB RENALDI PHONE: Business _____ Home 892-1201

ADDRESS 256 Lakeshore Dr. Mooresville, NC. 28115

LOCATION Jamie Wind Ct. / Faith Rd. TL Jamie Wind TR on Jamie Wind to end on (R)

SUBDIVISION Sunshake BLOCK / SECTION _____ LOT 7 LOT AREA 1.085 SITE CLASS. 1 DESIGN FLOW 360 L.T.A.R. .3

Septic Tank: 1000 Gallons; STB 794 Date 8/31/95

Pump Tank: _____ Gallons; PT _____ Date _____

Pump Make: _____ Model _____ Serial No. _____

Nitrification Field: No Fields 1 Square Feet 1200 Linear Feet 400

No Lines 4 Trench Width 36" Max Trench Bottom Depth 36"

☒ New System ☐ Repair System Type: I, (II), III, IV, V, VI

System Description: CONVENTIONAL - DIST. BOX

Repair System Description: _____

Maintenance Agreement Required: ☐ Yes ☒ No

Gravel Depth _____

☒ House/Mod. Home No. Bedrooms 3

☐ Mobile Home No. Bathrooms 2

☐ Business No. Employees _____

☐ Other _____


☐ Slab ☒ Crawl Space ☐ Basement w/plumbing ☐ Basement wo/plumbing

Water Supply: ☒ Individual ☐ Community ☐ Public

Comments:

Comments:

INITIAL SITE SKETCH

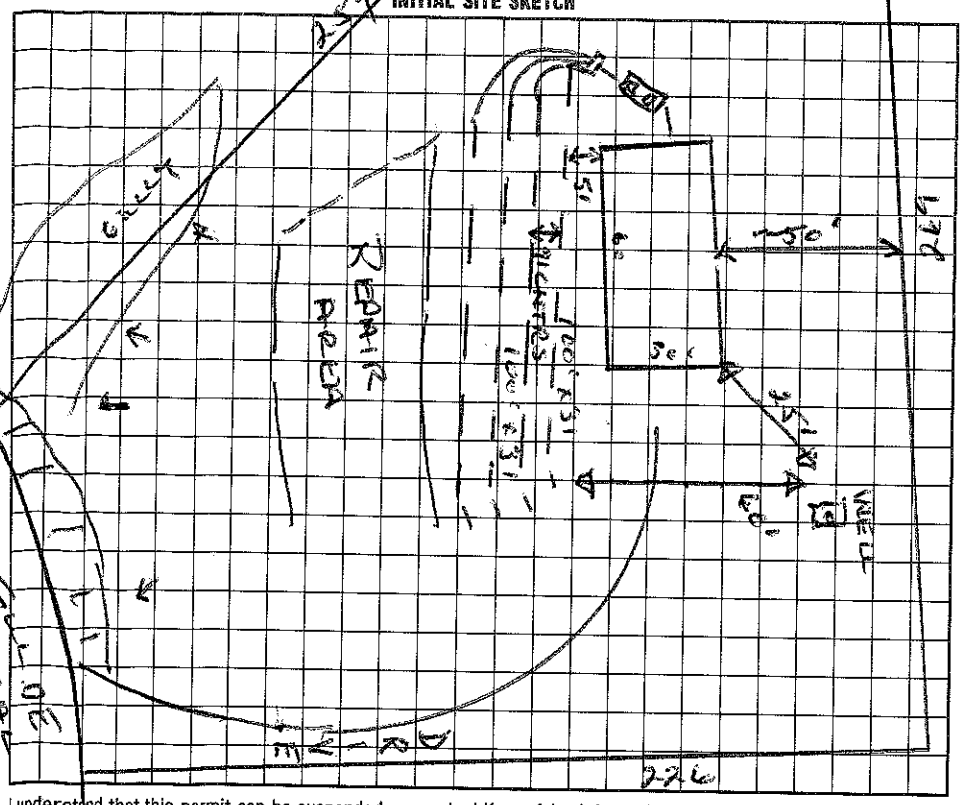

AS BUILT SKETCH

I understand that this permit can be suspended or revoked if any false information is supplied toward securing the permit/any unauthorized changes are made to the site/any unauthorized changes are made in the installation of the system. Improvement Permit is valid for 60 months from date of issuance.

Signed: _____

Improvement Permit by: Wesley D. Sparks RS date 10/3/94

Existing System Inspection by: _____ date _____

Installed by: McCarty Company

Certificate of Completion by: Wesley Sparks RS. date 12/11/95

Operation Permit by: Wesley Sparks RS. date 12/11/95

HEALTH DEPT. COPY: WHITE INSPECTION COPY (FINAL): GREEN OWNER COPY (FINAL): YELLOW INSPECTION COPY (INITIAL): PINK OWNER COPY (INITIAL): GOLD