2:30-3:00

IREDELL COUNTY HEALTH DEPARTMENT

Authorization to Construct

STATESVILLE 704-878-5305 MOORESVILLE 704-664-5281

IMPROVEMENT PERMIT / ~~CERTIFICATE OF COMPLETION~~ / OPERATION PERMIT / EXISTING SYSTEM INSPECTION

PROPERTY DESCRIPTION NO. 25930 DATE 2/5/97 TAX MAP NO. 4655468427 Watershed: [X] Yes [ ] No

OWNER OR CONTRACTOR Anne Hendrick PHONE: Business Home 892-4054

ADDRESS 297 Faith Rd. Mt Mourne, NC. PO Box 93 28123

LOCATION Faith Rd. TL Jenny Marie TR Jamie Wind Ct. on (D) before cul de sac

SUBDIVISION Serene Lake BLOCK / SECTION LOT 10 LOT AREA ~1.34c SITE CLASS. PS DESIGN FLOW 360 L.T.A.R. < 3

Septic Tank: 1000 Gallons; STB B794 Date ~~2/4~~ 2/5/97

Pump Tank: Gallons; PT Date

Pump Make: Model Serial No.

Nitrification Field: No Fields 1 Square Feet 1200 Linear Feet 400

No Lines 4 Trench Width 36" Max Trench Bottom Depth 36" Gravel Depth 12"

[X] New System [ ] Repair System Type: I (II) III, IV, V, VI

System Description: GRAV - CONVENTIONAL

Repair System Description: SAME

Maintenance Agreement Required: [ ] Yes [X] No

[X] House/Mod. Home No. Bedrooms 3

[ ] Mobile Home No. Bathrooms 2

[ ] Business No. Employees

[ ] Other


[ ] Slab [X] Crawl Space [ ] Basement w/plumbing [ ] Basement wo/plumbing

Water Supply: [X] Individual [ ] Community [ ] Public


Comments:

Comments:

INITIAL SITE SKETCH

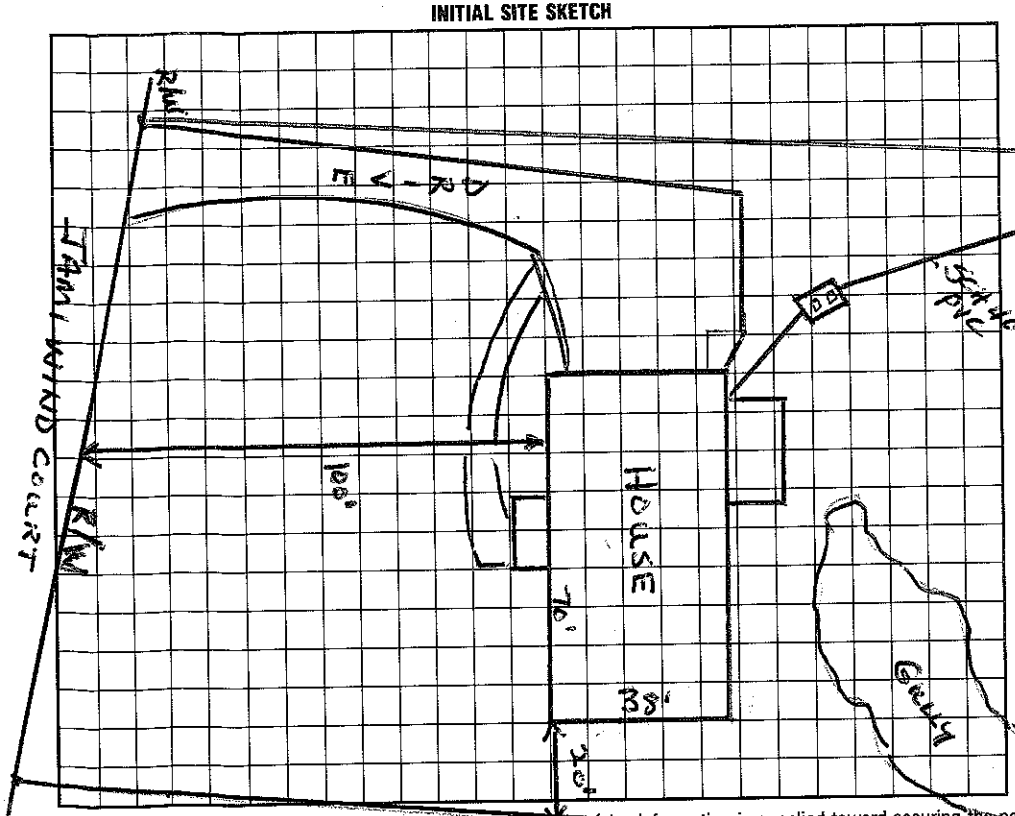

AS BUILT SKETCH

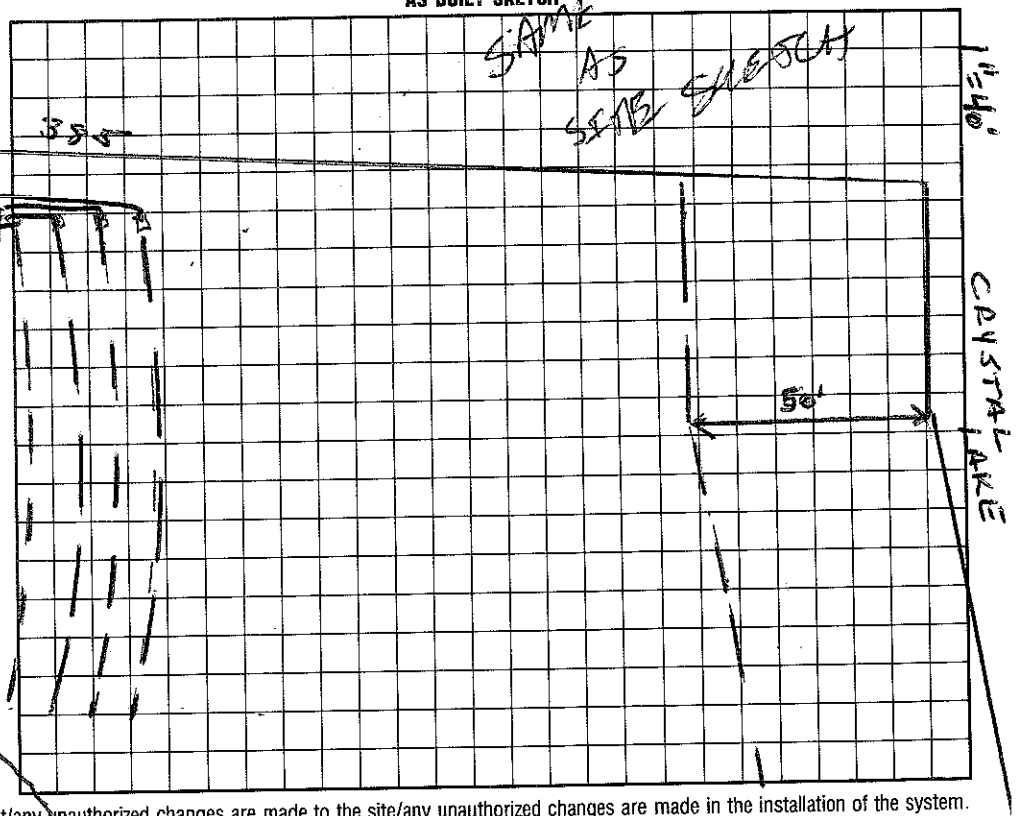

I understand that this permit can be suspended or revoked if any false information is supplied toward securing this permit/any unauthorized changes are made to the site/any unauthorized changes are made in the installation of the system. Improvement Permit is valid for 60 months from date of issuance.

Signed: * Kent Hendrick

Improvement Permit by: Wesley Sparks RS. date 2/5/97

Existing System Inspection by: * Kent Hendrick Wesley Sparks RS. date 2/5/97

Installed by: LAM-Y BROS

Certificate of Completion by: date

Operation Permit by: C date 8/7/97

HEALTH DEPT. COPY: WHITE INSPECTION COPY (FINAL): GREEN OWNER COPY (FINAL): YELLOW INSPECTION COPY (INITIAL): PINK OWNER COPY (INITIAL): GOLD