IREDELL COUNTY HEALTH DEPARTMENT

STATESVILLE 704-878-5305 (1) MOORESVILLE 704-664-5281

IMPROVEMENT PERMIT / AUTHORIZATION TO CONSTRUCT / OPERATION PERMIT / EXISTING SYSTEM INSPECTION

PERMIT# 073329 PIN# 4655 47 1157 DATE 1/22/02

OWNER OR CONTRACTOR Richard Butler PHONE: Business 892-4420 Home

ADDRESS PO Box 371 Mt Mourne, NC. 28123

LOCATION 1155 TL Faith Rd. TL Jenny Marie Dr. next to last lot on (L)

SUBDIVISION Serene Lake BLOCK / SECTION LOT 5 LOT AREA .6AC SITE CLASS. PS DESIGN FLOW 360 L.T.A.R. .3

Septic Tank: 1000 Gallons; STB 794 Date 3/2/02
Pump Tank: Gallons; PT Date
Pump Make: Model Serial No.
Nitrification Field: No Fields 1 Square Feet 900 * Linear Feet 300 *
No Lines 3@100' Trench Width 3' Max Trench Bottom Depth 32" Gravel Depth N/A

☑ New System ☐ Repair System Type: I, II, (III) IV, V, VI
System Description: Quality-CHPLAS-EZ FLO
Repair System Description: Some
Maintenance Agreement Required: ☐ Yes ☒ No


☒ House/Mod. Home ☐ Mobile Home ☐ Business ☐ Other
No. Bedrooms 3 No. Bathrooms 2.5 No. Employees
☐ Slab ☒ Crawl Space ☐ Basement w/plumbing ☐ Basement wo/plumbing

Water Supply: ☒ Individual ☐ Public ☐ Community

Comments:/Conditions:

(1" = 50')

INITIAL SITE SKETCH

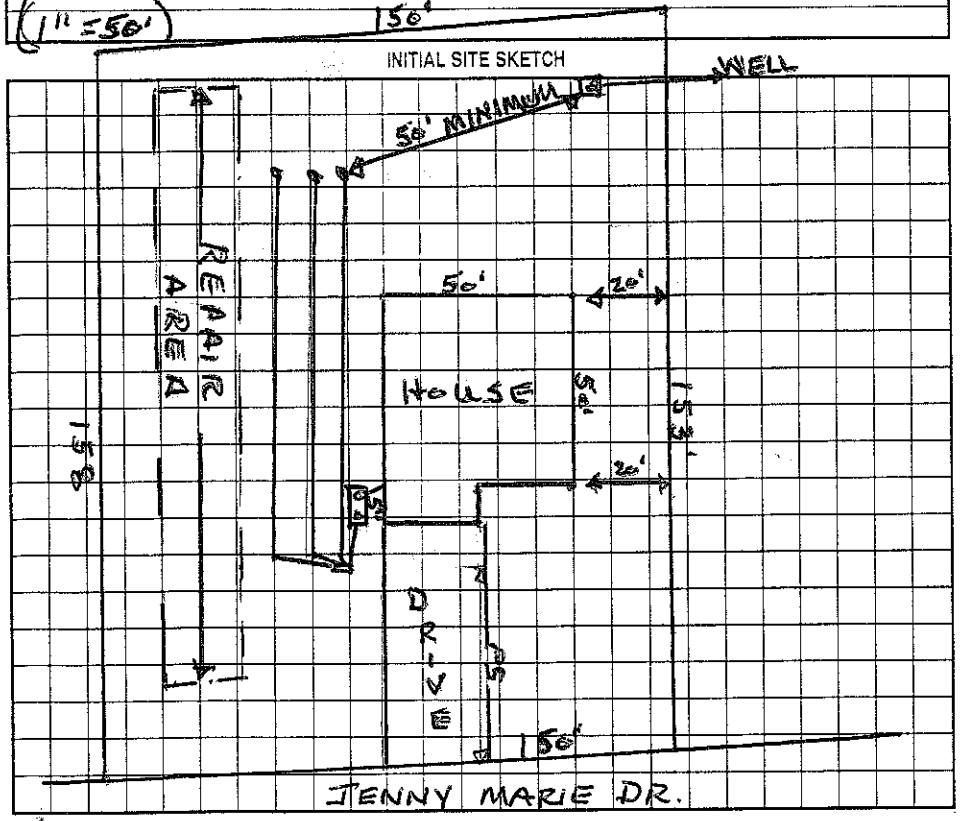

Comments:/Conditions:

AS BUILT SKETCH

Permit can be suspended or revoked if any false information is supplied toward securing the permit/any unauthorized changes are made to the site/any unauthorized changes are made in the installation of the system. Improvement Permit with plat valid without expiration. Improvement Permit with site plan valid for sixty months. Authorization to Construct is valid for a period equal to that of Improvement Permit – not to exceed sixty months.

Signed: * Kimberly D Butler date 1-23-02 Installed by: Curt Dunning Const.

Improvement Permit by: Wesley Sparks R.S. date 1/22/02 Operation Permit by: Wesley Sparks R.S. date 12/3/02

Authorization to Construct by: Wesley Sparks R.S. date 1/22/02 Existing System Inspection by: date

HEALTH DEPT. COPY: WHITE OWNER COPY (FINAL): YELLOW OWNER COPY (INITIAL): PINK