IREDELL COUNTY HEALTH DEPARTMENT

STATESVILLE 704-878-5305 MOORESVILLE 704-664-5281

IMPROVEMENT PERMIT / AUTHORIZATION TO CONSTRUCT / OPERATION PERMIT / EXISTING SYSTEM INSPECTION

PERMIT# 092898 PIN# 4655 47 2303 DATE 11/13/00

OWNER OR CONTRACTOR Richard L Butler PHONE: Business _____ Home 892-4420

ADDRESS 157 Jenny Marie Ct. Mooresville, NC. 28115

LOCATION 1155 TL Faith Rd TL Jenny Marie to # 157 on (L) near end

SUBDIVISION Serene Lake BLOCK / SECTION _____ LOT 6 LOT AREA ~.5 SITE CLASS. _____ DESIGN FLOW 360 L.T.A.R. _____

Septic Tank: EXISTING Gallons; STB _____ Date _____

Pump Tank: _____ Gallons; PT _____ Date _____

Pump Make: _____ Model _____ Serial No. _____

Nitrification Field: No Fields ~~Existing~~ Square Feet 900 Linear Feet 300

No Lines 3@100' Trench Width 3' Max Trench Bottom Depth 36" Gravel Depth _____

☐ New System ☐ Repair System Type: I (II) III, IV, V, VI

System Description: Existing System

Repair System Description: _____

Maintenance Agreement Required: ☐ Yes ☐ No

☒ House/Mod. Home No. Bedrooms 3

☐ Mobile Home No. Bathrooms 2.5

☐ Business No. Employees ____

☐ Other Kitchen-Bath-Bedroom Addition

☐ Slab ☒ Crawl Space ☐ Basement w/plumbing ☐ Basement wo/plumbing

Water Supply: ☒ Individual ☐ Public ☐ Community


Comments:/Conditions:

Comments:/Conditions:

No evidence of problem.

INITIAL SITE SKETCH

AS BUILT SKETCH

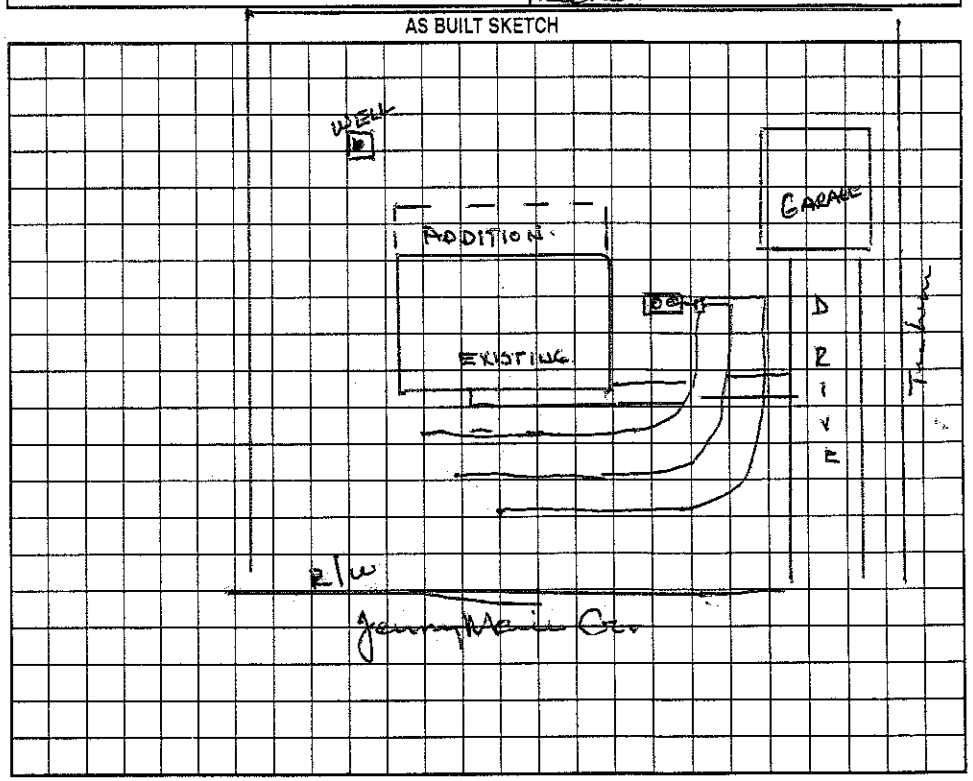

Permit can be suspended or revoked if any false information is supplied toward securing the permit/any unauthorized changes are made to the site/any unauthorized changes are made in the installation of the system. Improvement Permit with plat valid without expiration. Improvement Permit with site plan valid for sixty months. Authorization to Construct is valid for a period equal to that of Improvement Permit – not to exceed sixty months.

Signed: _____ date _____

Improvement Permit by: _____ date _____

Authorization to Construct by: _____ date _____

Installed by: _____

Operation Permit by: _____ date _____

Existing System Inspection by: Wesley Sparks RS date 11/13/00

HEALTH DEPT. COPY: WHITE OWNER COPY (FINAL): YELLOW OWNER COPY (INITIAL): PINK