IREDELL COUNTY HEALTH DEPARTMENT

STATESVILLE 704-878-5305 MOORESVILLE 704-664-5281

4V5551402O

IMPROVEMENT PERMIT / CERTIFICATE OF COMPLETION / OPERATION PERMIT / EXISTING SYSTEM INSPECTION

PROPERTY DESCRIPTION NO. 17705 DATE 4/29/94 TAX MAP NO. IC A 109 Watershed: ☑ Yes ☐ No

OWNER OR CONTRACTOR Steven Bailey PHONE: Business 892-2300 Home 892-1809

ADDRESS Rt 1 Box 119 Mooresville, NC. 28115

LOCATION Nance Farm Rd © off Midway Lake to 3rd trailer on (L) past mobile to lot at rear.

SUBDIVISION N/A BLOCK / SECTION ____ LOT ____ LOT AREA 2+1.5AC SITE CLASS. P DESIGN FLOW 360 L.T.A.R. .25-.3

Septic Tank: 1000 Gallons; STB 825 Date 4/14/98

Pump Tank: ____ Gallons; PT ____ Date ____

Pump Make: ____ Model ____ Serial No. ____

Nitrification Field: No Fields 1 Square Feet 1200 Linear Feet 400

No Lines 4 Trench Width 36" Max Trench Bottom Depth 36" Gravel Depth 12"

☑ New System ☐ Repair System Type: I (II) III, IV, V, VI

System Description: CONV - DIST BOX

Repair System Description: ____

Maintenance Agreement Required: ☐ Yes ☑ No

☐ House/Mod. Home No. Bedrooms 3

☑ Mobile Home No. Bathrooms 2

☐ Business No. Employees ____

☐ Other ____


☑ Slab ☐ Crawl Space ☐ Basement w/plumbing ☐ Basement wo/plumbing

Water Supply: ☑ Individual ☐ Community ☐ Public PROPOSED


Comments:
"Trench depth no more than 36"
Lines on slope contour.

Comments: (30 © 133' x 3')

INITIAL SITE SKETCH

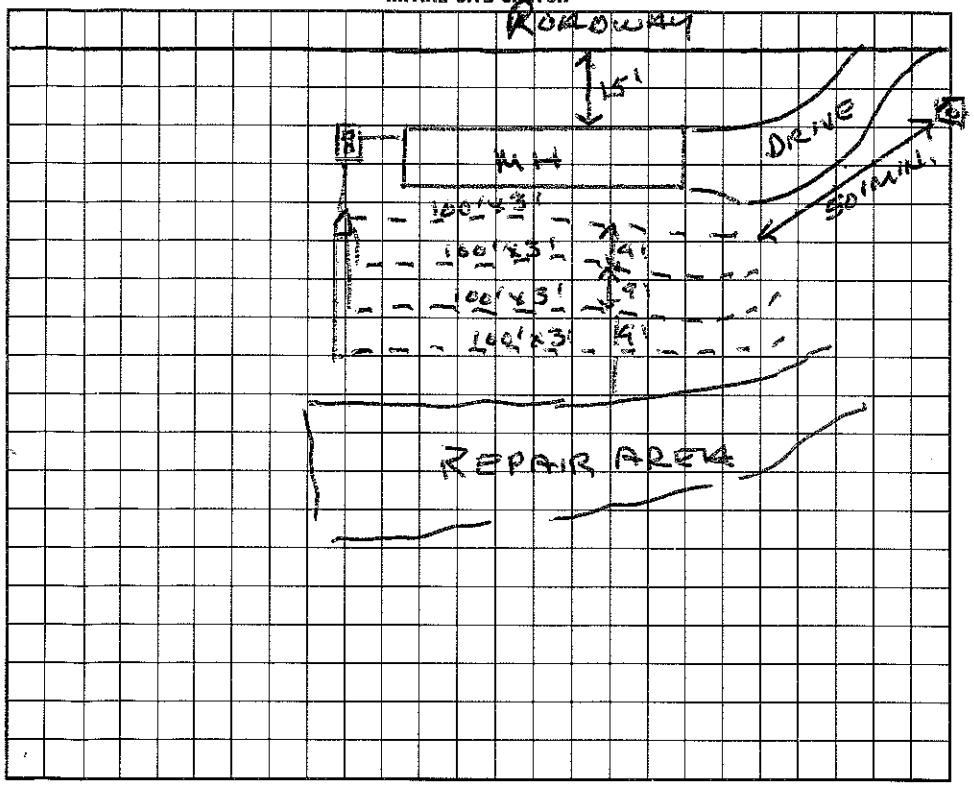

AS BUILT SKETCH

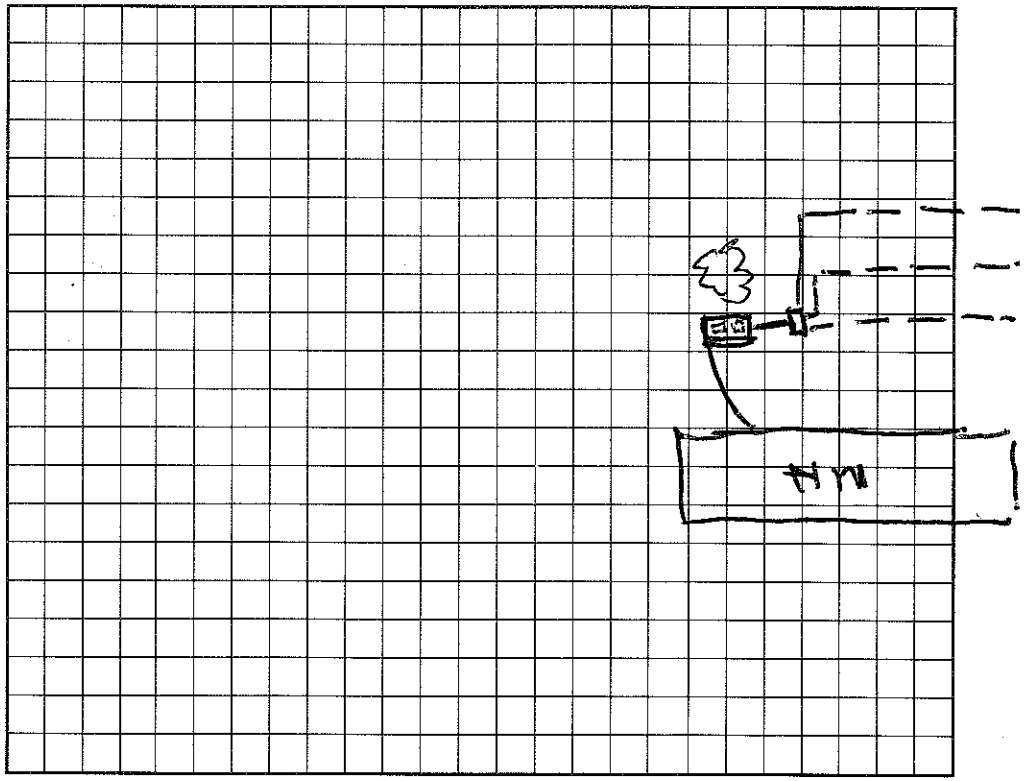

I understand that this permit can be suspended or revoked if any false information is supplied toward securing the permit/any unauthorized changes are made to the site/any unauthorized changes are made in the installation of the system. Improvement Permit is valid for 60 months from date of issuance.

Signed: x Steve Bailey

Improvement Permit by: Wesley Sparks RS. date 4/29/94

Existing System Inspection by: ____ date ____

Installed by: K & K Grading

Certificate of Completion by: Wesley Sparks RS. date 6/29/98

Operation Permit by: Wesley Sparks RS. date 6/29/98

HEALTH DEPT. COPY: WHITE INSPECTION COPY (FINAL): GREEN OWNER COPY (FINAL): YELLOW INSPECTION COPY (INITIAL): PINK OWNER COPY (INITIAL): GOLD