4655515849

IREDELL COUNTY HEALTH DEPARTMENT

STATESVILLE 704-878-5305 MOORESVILLE 704-664-5281

IMPROVEMENT PERMIT / AUTHORIZATION TO CONSTRUCT / OPERATION PERMIT / EXISTING SYSTEM INSPECTION

PERMIT# 140584 PIN# 4655515888 DATE 2-23-07

OWNER OR APPLICANT Freedom Homes owner: Dick Jordan PHONE: Business 704-872-0179 Home

ADDRESS 1270 Northside Dr Statesville

LOCATION 115 S TL Faith TR Midway Lake TR Nance Farm Rd TL Tessies Ln 2nd on right (112)

SUBDIVISION BLOCK / SECTION LOT LOT AREA SITE CLASS. DESIGN FLOW L.T.A.R.

Septic Tank: Existing Gallons: STB Date
Pump Tank: Gallons: PT Date
Pump Make: Model Serial No.
Nitrification Field: No Fields Square Feet Linear Feet
No Lines Trench Width Max Trench Bottom Depth Gravel Depth ☒ Gravity ☐ Pressure

☐ New System ☐ Repair ☐ Expansion System Type: I (II) III IV V VI
System Description: Existing
Repair System Description:
Maintenance Agreement Required: ☐ Yes ☐ No

☐ House/Mod. Home No. Bedrooms 3
☒ Mobile Home No. Persons 6
☐ Business No. Employees
☐ Other

Water Supply: ☒ Individual ☐ Public ☐ Community

☐ Slab ☐ Crawl Space ☐ Basement w/plumbing ☐ Basement wo/plumbing


Comments:/Conditions:

1" = 60'

INITIAL SITE SKETCH

Comments:/Conditions: system undersized according to today's standards

AS BUILT SKETCH

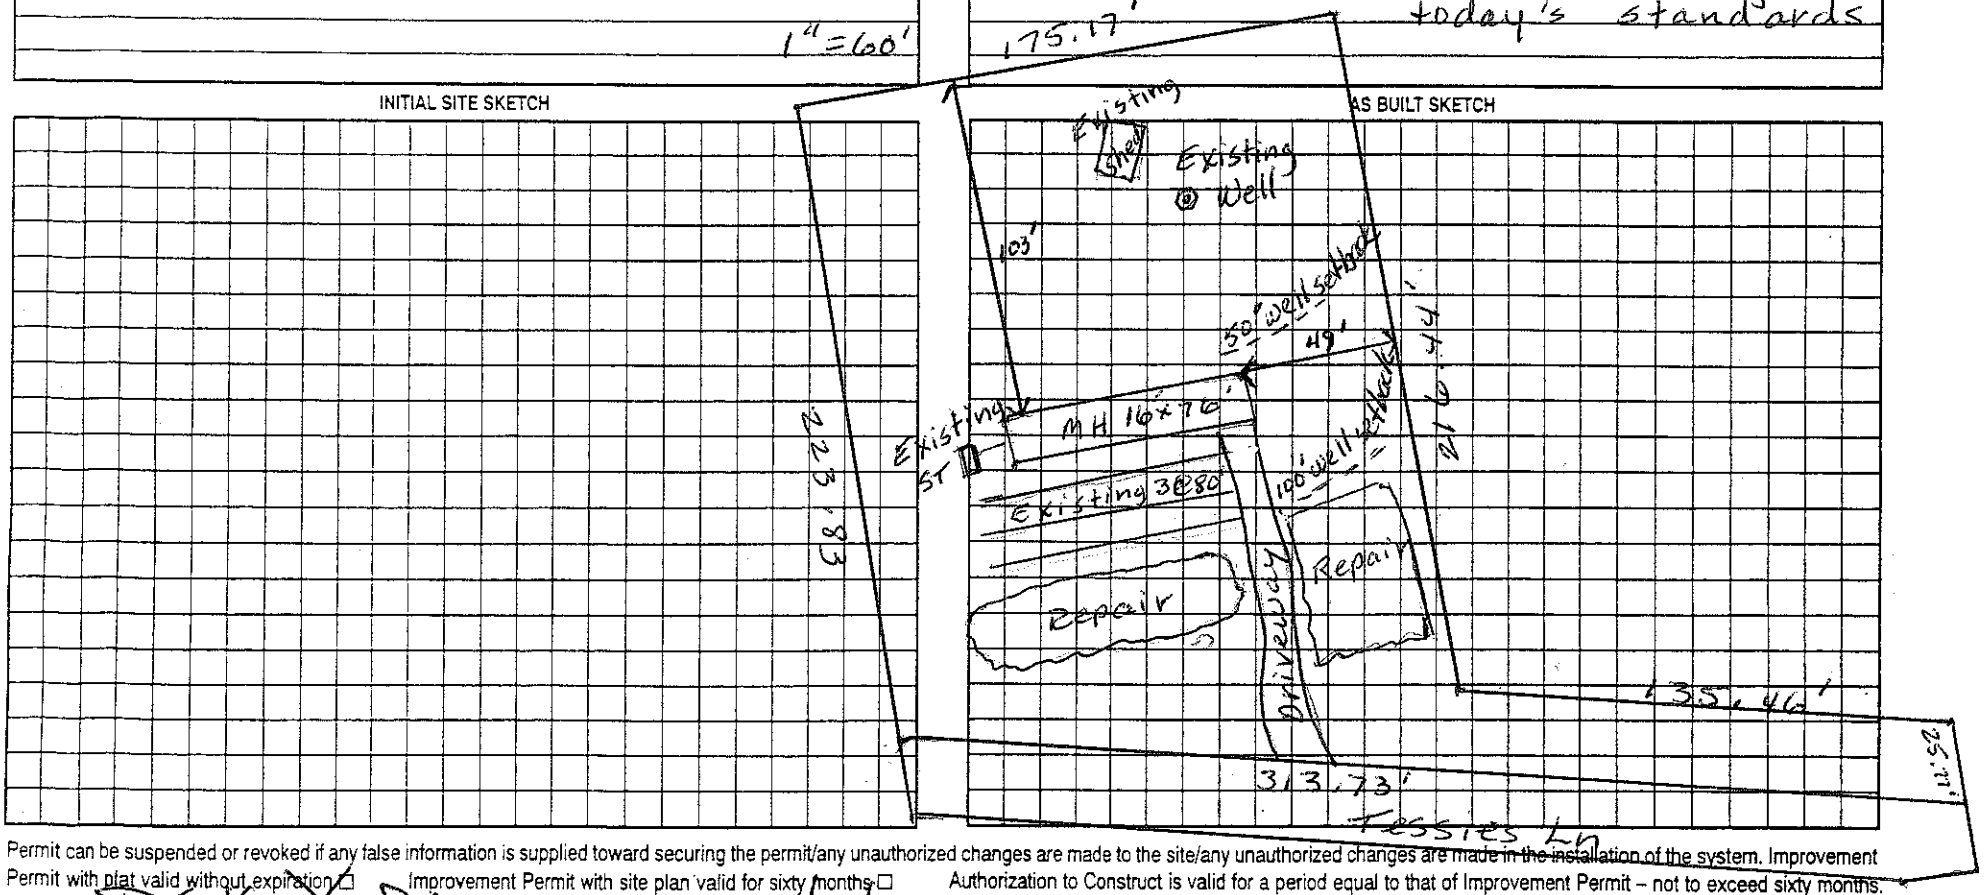

Permit can be suspended or revoked if any false information is supplied toward securing the permit/any unauthorized changes are made to the site/any unauthorized changes are made in the installation of the system. Improvement Permit with plat valid without expiration ☐ Improvement Permit with site plan valid for sixty months ☐ Authorization to Construct is valid for a period equal to that of Improvement Permit – not to exceed sixty months.

Signed: Dick Jordan date 2/26/07 Installed by:

Improvement Permit by: date Operation Permit by: date

Authorization to Construct by: date Existing System Inspection by: Judy Melville date 2-23-07

HEALTH DEPT. COPY: WHITE OWNER COPY (FINAL): YELLOW OWNER COPY (INITIAL): PINK