IREDELL COUNTY HEALTH DEPARTMENT

Statesville Office (704) 878-5305 Mooresville Office (704) 660-3625 PERMIT # 2036060

IMPROVEMENT PERMIT / AUTHORIZATION TO CONSTRUCT / OPERATION PERMIT / EXISTING SYSTEM

PIN # 4655540886

APPLICANT: Joel Wesley Norris APPLICANT ADDRESS: 149 Midway Lake Rd. Mooresville, NC

SITE ADDRESS: 163 Midway Lake Rd Mooresville, NC PHONE: 704 699-7107 ALT. PHONE: 704 892-1943

SITE DIRECTIONS: Hwy 115 S. TL Faith Rd TR Midway Lake Rd ~ 1/8 mile on left

SUBDIVISION: SECTION: LOT # LOT AREA: ~ 1.4Ac. DESIGN FLOW: *360gpd L.T.A.R.:

EXIST

Septic Tank 1000 (gal) STB Date
Pump Tank (gal) PT Date
Pump Make Model Serial #
Nitrification Fields 1 # Lines 3 Linear Ft: 300
Trench Width 36" Max. Trench Bottom Depth — Gravel Depth 12"

☐ New System ☐ Repair ☐ Expansion System Type: I (II) III IV V VI

EXIST

System Description: Gravity Conventional
Repair System Description:
Maintenance Agreement Required: ☐ YES ☒ NO
☒ GRAVITY ☐ PRESSURE

☒ Residence ☐ Business ☐ Other ☐ Slab ☐ Basement w/plumbing
No. Bedrooms *3 No. Persons No. Employees
☒ Crawl Space ☐ Basement w/o plumbing


Water Supply: ☒ Private ☐ Public ☐ Community

Comments / Conditions: Existing Septic System "appears" to be functioning okay at time of inspection
*Must keep new home at least 5ft from Septic System (Including Decks & Porches)

*Original Septic permit dated 9-15-87 was sized for 3 Bedrooms, application dated 5-22-14 was only for 2 Bedrooms

INITIAL SITE SKETCH

Scale 1:60

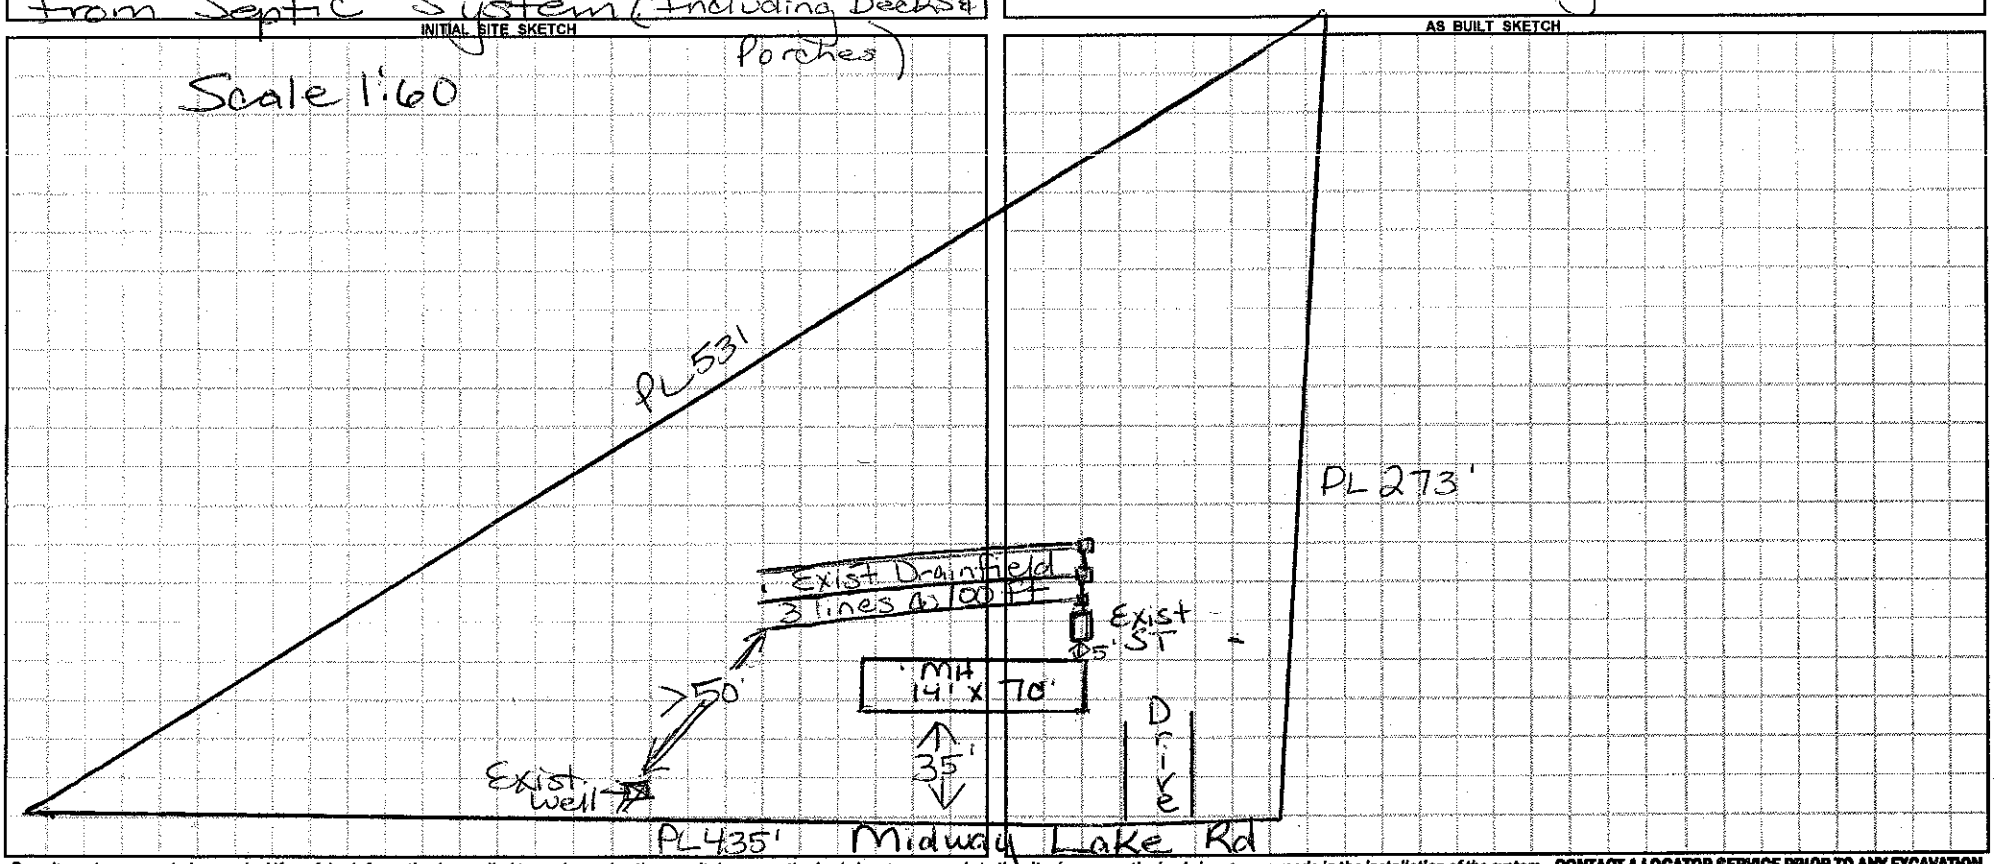

AS BUILT SKETCH

Permit can be suspended or revoked if any false information is supplied toward securing the permit / any unauthorized changes are made to the site / any unauthorized changes are made in the installation of the system. **CONTACT A LOCATOR SERVICE PRIOR TO ANY EXCAVATION**

☐ **IMPROVEMENT PERMIT** *with plat valid without expiration.* ☐ **IMPROVEMENT PERMIT** *with site plan valid for 60 mos.* ☐ **AUTHORIZATION TO CONSTRUCT** *valid for period equal to IMPROVEMENT PERMIT--not to exceed 60 mo.*

Owner / Applicant Signature: X Joel W Norris Date: 7-24-14 Installed by:

IMPROVEMENT PERMIT by: Date: OPERATION PERMIT by: Date:

AUTHORIZATION TO CONSTRUCT by: Date: Existing System Inspected by: Mark Dotson RS Date: 7/23/14

Health Dept. Copy - WHITE Applicant (Final Approval) - YELLOW Applicant (Conditional Approval) - PINK