2-2130

IREDELL COUNTY HEALTH DEPARTMENT

STATESVILLE 704-878-5305 MOORESVILLE 704-664-5281

IMPROVEMENT PERMIT / AUTHORIZATION TO CONSTRUCT / OPERATION PERMIT / EXISTING SYSTEM INSPECTION

PERMIT# 148412 PIN# 4655542230 DATE 3-7-08

OWNER OR APPLICANT Thomas + Kristy Hagar PHONE: Business 704-746-5527 Home

ADDRESS 114 Nachatta Dr, Mooresville NC 28115

LOCATION 1155, TL Faith Rd, TR Midway Lake Rd, Lot on Right

SUBDIVISION — BLOCK / SECTION — LOT — LOT AREA .666 Acs SITE CLASS. PS DESIGN FLOW 240 L.T.A.R. .3

Septic Tank: 1000 Gallons: STB 312-1000 Date 12-26-07
Pump Tank: Gallons: PT Date
Pump Make: Model Serial No.
Nitrification Field: No Fields 1 Square Feet 600' Linear Feet 200'
No Lines 3 Trench Width 36" Max Trench Bottom Depth 36" Gravel Depth —

[X] New System [ ] Repair [ ] Expansion System Type: I II (III) IV V VI
System Description: Gravity 25% Red
Repair System Description: 25% Red
Maintenance Agreement Required: [ ] Yes [X] No

[ ] House/Mod. Home No. Bedrooms 2
[X] Mobile Home No. Persons 3
[ ] Business No. Employees
[ ] Other


Water Supply: [X] Individual [ ] Public [ ] Community

[X] Gravity [ ] Pressure [ ] Slab [X] Crawl Space [ ] Basement w/plumbing [ ] Basement wo/plumbing

Comments:/Conditions: Set tank 15' from trailer corner / Use drop box distribution / 2 lines @ 75' + 1 line @ 50'

Comments:/Conditions:

INITIAL SITE SKETCH 1" = 50'

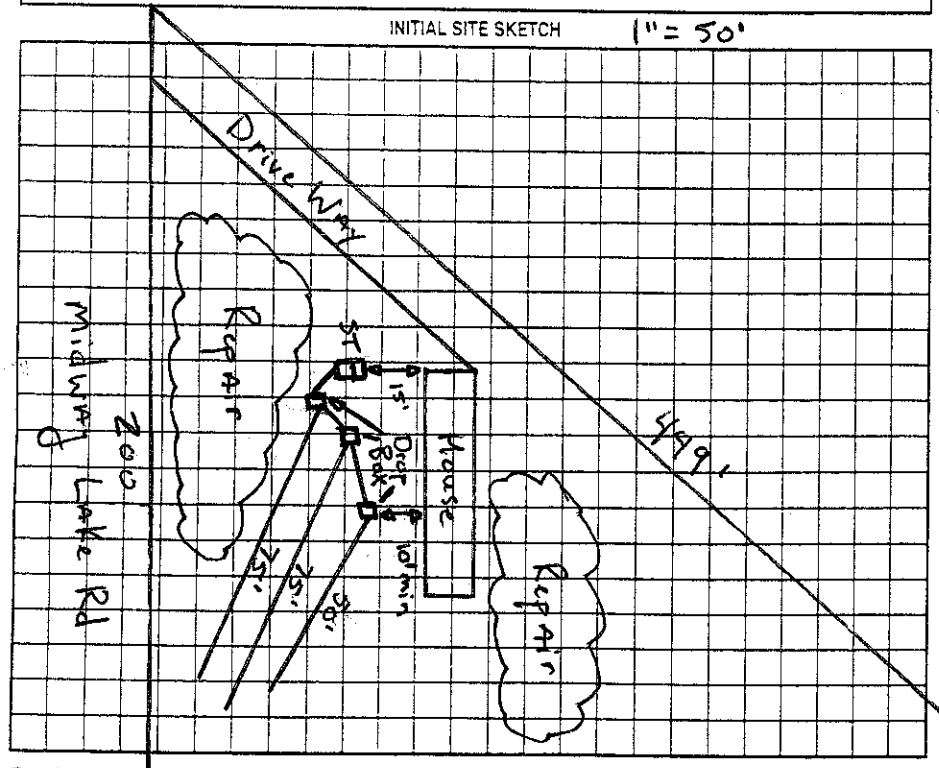

AS BUILT SKETCH

Permit can be suspended or revoked if any false information is supplied toward securing the permit/any unauthorized changes are made to the site/any unauthorized changes are made in the installation of the system. Improvement Permit with plat valid without expiration [ ] Improvement Permit with site plan valid for sixty months [X] Authorization to Construct is valid for a period equal to that of Improvement Permit – not to exceed sixty months.

Signed: date

Improvement Permit by: date 3-7-08

Authorization to Construct by: date 3-11-08

Installed by: Benny

Operation Permit by: date 4-15-08

Existing System Inspection by: date

HEALTH DEPT. COPY: WHITE OWNER COPY (FINAL): YELLOW OWNER COPY (INITIAL): PINK