PIN# 4655-55-3594

IREDELL COUNTY HEALTH DEPARTMENT

STATESVILLE 704-878-5305 MOORESVILLE 704-664-5281

IMPROVEMENT PERMIT / CERTIFICATE OF COMPLETION / OPERATION PERMIT / EXISTING SYSTEM INSPECTION

PROPERTY DESCRIPTION NO. 18569 DATE 5/25/94 TAX MAP NO. ID-A - 44 Watershed: ☐ Yes ☐ No

OWNER OR CONTRACTOR Broadmoore Homes Inc. PHONE: Business 663-7660 Home

ADDRESS PO Box 1242 Mooresville, NC. 28115

LOCATION FAITH RD. 1115 S TL FAITH RD. ON (L) JUST PAST MCTT RD.

SUBDIVISION ENGLISH HILLS BLOCK / SECTION LOT 4 LOT AREA .516 AC SITE CLASS. P DESIGN FLOW 360 L.T.A.R. .3-.35

Septic Tank: 1000 Gallons; STB 825 Date 5/26/94

Pump Tank: Gallons; PT Date

Pump Make: Model Serial No.

Nitrification Field: No Fields 1 Square Feet ~~400~~ 1200 Linear Feet 400

No Lines 5 Trench Width 3' Max Trench Bottom Depth 33-34" Gravel Depth 12"

☑ New System ☐ Repair System Type: I (II) III, IV, V, VI

System Description: DIST. BOX - CONV. TRENCH

Repair System Description:

Maintenance Agreement Required: ☐ Yes ☑ No

☑ House/Mod. Home No. Bedrooms 3

☐ Mobile Home No. Bathrooms 2

☐ Business No. Employees

☐ Other


☐ Slab ☑ Crawl Space ☐ Basement w/plumbing ☐ Basement wo/plumbing

Water Supply: ☑ Individual ☐ Community ☐ Public


Comments: TIGHT - VERY TIGHT
Any changes will mean going to PPBP Schaufuld for original and repair depth.

Comments:

INITIAL SITE SKETCH

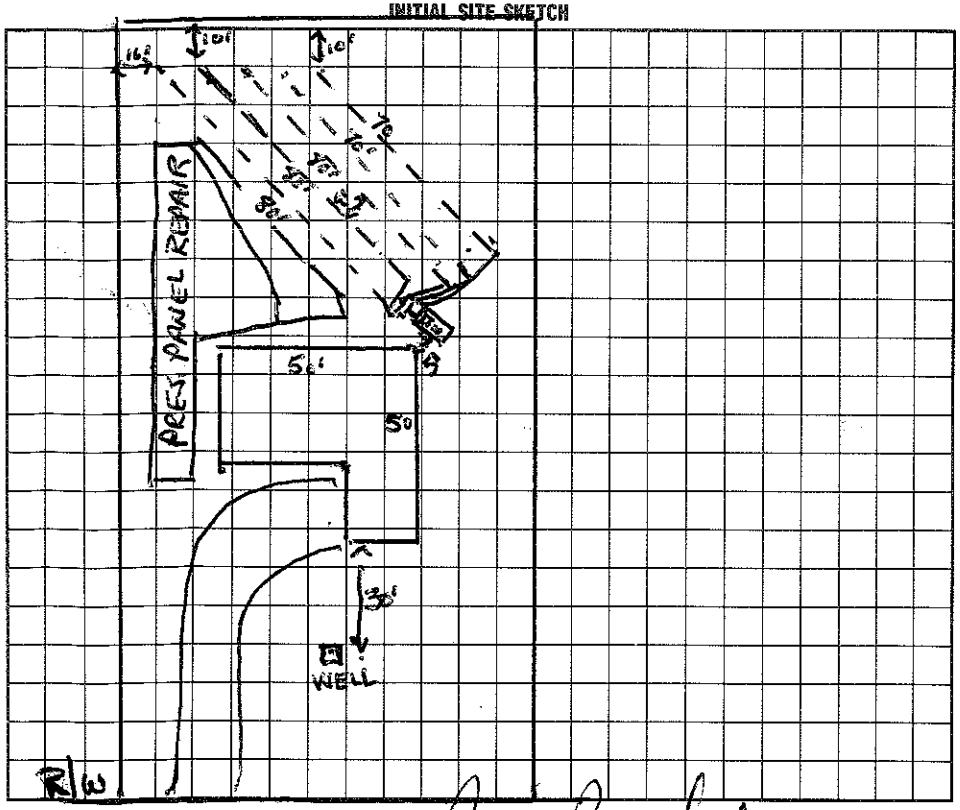

AS-BUILT SKETCH

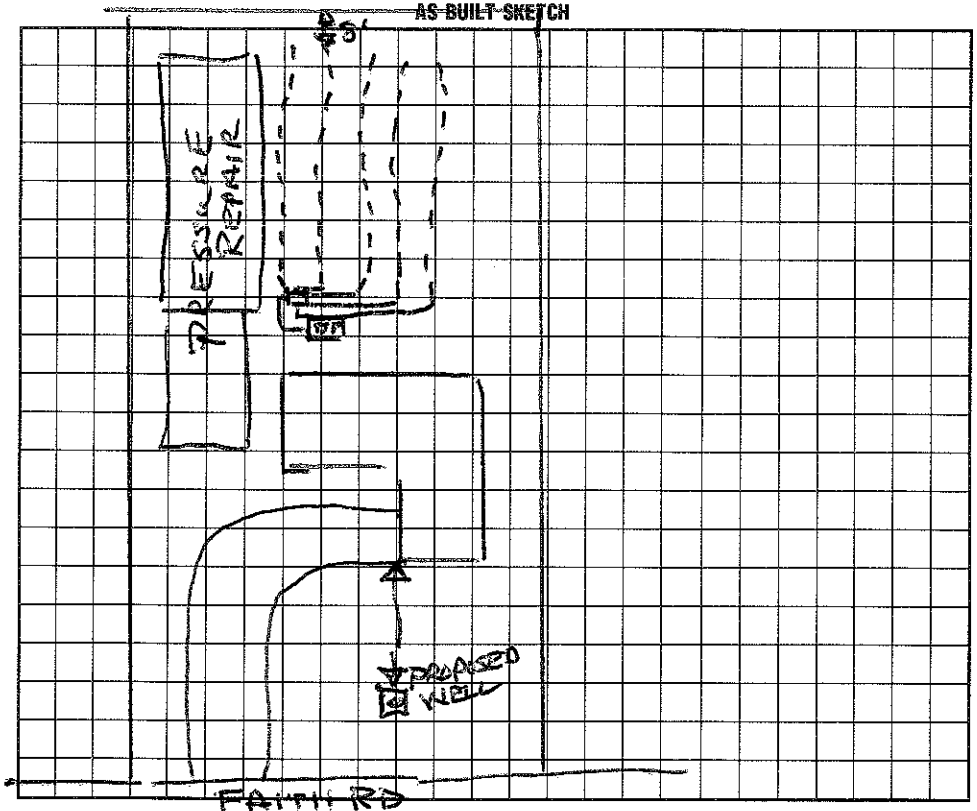

I understand that this permit can be suspended or revoked if any false information is supplied toward securing the permit/any unauthorized changes are made to the site/any unauthorized changes are made in the installation of the system. Improvement Permit is valid for 60 months from date of issuance.

Signed: FAITH RD. Paul Broadmoore

Improvement Permit by: Wesley Sparks R.S. date 5/25/94

Existing System Inspection by: date

Installed by: Curt Dunning

Certificate of Completion by: Wesley Sparks, R.S. date 9/14/94

Operation Permit by: date

HEALTH DEPT. COPY: WHITE INSPECTION COPY (FINAL): GREEN OWNER COPY (FINAL): YELLOW INSPECTION COPY (INITIAL): PINK OWNER COPY (INITIAL): GOLD