PIN# 4655-55-4581

IREDELL COUNTY HEALTH DEPARTMENT

STATESVILLE 704-878-5305 MOORESVILLE 704-664-5281

IMPROVEMENT PERMIT / CERTIFICATE OF COMPLETION / OPERATION PERMIT / EXISTING SYSTEM INSPECTION

PROPERTY DESCRIPTION NO. 18643 DATE 7/15/94 TAX MAP NO. 1D A44 Pt of. Watershed: ☐ Yes ☑ No

OWNER OR CONTRACTOR Bill Mott (Broadmoor Homes) PHONE: Business 663-7663 Home

ADDRESS PO Box 1242 Mooresville, NC 28115

LOCATION Faith Rd from 1153 on (L) past 1137 SR, 2nd on (L)

SUBDIVISION English Hills BLOCK / SECTION 1 LOT 3 LOT AREA ~.50 SITE CLASS. P DESIGN FLOW 360 L.T.A.R. .3-.35

Septic Tank: 1000 Gallons; STB 825 Date 10/11/94

Pump Tank: Gallons; PT Date

Pump Make: Model Serial No.

Nitrification Field: No Fields 1 Square Feet 1028 Linear Feet 342

No Lines 4 Trench Width 3' Max Trench Bottom Depth 3' Gravel Depth 12

☑ New System ☐ Repair System Type: I (II) III, IV, V, VI

System Description: Conv - DRcP Box

Repair System Description:

Maintenance Agreement Required: ☐ Yes ☐ No

☑ House/Mod. Home No. Bedrooms 3

☐ Mobile Home No. Bathrooms 2

☐ Business No. Employees

☐ Other

☐ Slab ☑ Crawl Space ☐ Basement w/plumbing ☐ Basement wo/plumbing


Water Supply: ☐ Individual ☑ Community ☐ Public

Comments:

Tricky contours - Large trees in way

Comments:

INITIAL SITE SKETCH

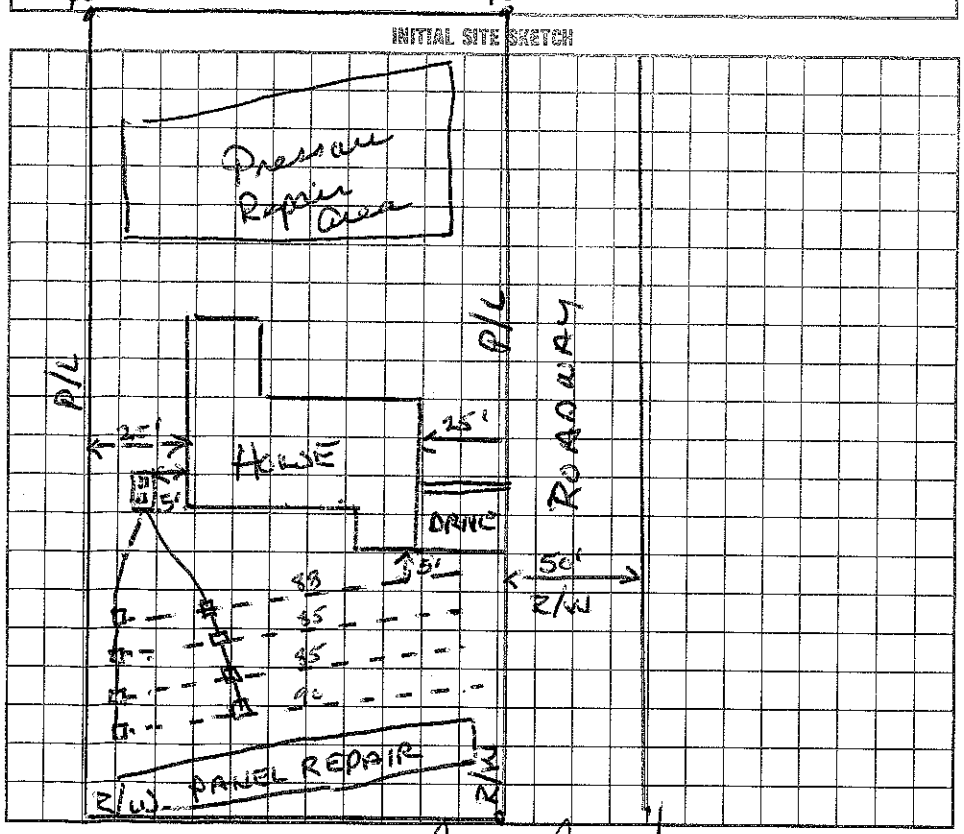

AS BUILT SKETCH

I understand that this permit can be suspended or revoked if any false information is supplied toward securing the permit/any unauthorized changes are made to the site/any unauthorized changes are made in the installation of the system. Improvement Permit is valid for 60 months from date of issuance.

Signed: FAITH RD Paul Brodbeck

Improvement Permit by: Wesley Sparks RS. date 7/15/94

Existing System Inspection by: date

Installed by: Curt Dunning

Certificate of Completion by: Wesley Sparks RS. date 12/7/94

Operation Permit by: date

HEALTH DEPT. COPY: WHITE INSPECTION COPY (FINAL): GREEN OWNER COPY (FINAL): YELLOW INSPECTION COPY (INITIAL): PINK OWNER COPY (INITIAL): GOLD