IREDELL COUNTY HEALTH DEPARTMENT

STATESVILLE 704-878-5305 MOORESVILLE 704-664-5281

PN# 4655-55-5607

IMPROVEMENT PERMIT / CERTIFICATE OF COMPLETION / OPERATION PERMIT / EXISTING SYSTEM INSPECTION

PROPERTY DESCRIPTION NO. 1845 DATE 9/14/94 TAX MAP NO. ID A 44 Watershed: ☐ Yes ☒ No

OWNER OR CONTRACTOR Broadmoor Const. (Bob Mott) PHONE: Business _____ Home 663-7666

ADDRESS 392 English Hills Rd. Mooresville NC. 28115

LOCATION ~~Hwy~~ Faith Rd (D) off 115 S, (L) at 1st entrance to 1st on (L) facing English Hills Dr.

SUBDIVISION English Hills BLOCK / SECTION 3 LOT 5 LOT AREA .84 SITE CLASS. P DESIGN FLOW 360 L.T.A.R. .30

Septic Tank: 1000 Gallons; STB 794 Date 2/3/95

Pump Tank: _____ Gallons; PT _____ Date _____

Pump Make: _____ Model (1200) Serial No. _____

Nitrification Field: No Fields ____ Square Feet ~~220~~ Linear Feet ~~220~~ 410

No Lines ~~5~~ 8 Trench Width 36" Max Trench Bottom Depth 30 Gravel Depth 12"

☒ New System ☐ Repair System Type: I (II) III, IV, V, VI

System Description: CONV - DIST BOX

Repair System Description: PRES. PANEL

Maintenance Agreement Required: ☐ Yes ☒ No

☒ House/Mod. Home No. Bedrooms 3

☐ Mobile Home No. Bathrooms 2

☐ Business No. Employees ____

☐ Other _____


☐ Slab ☒ Crawl Space ☐ Basement w/plumbing ☐ Basement wo/plumbing

Water Supply: ☒ Individual ☐ Community ☐ Public well


Comments:

Comments: Tc 7c 9c 4c 8c 40c

INITIAL SITE SKETCH

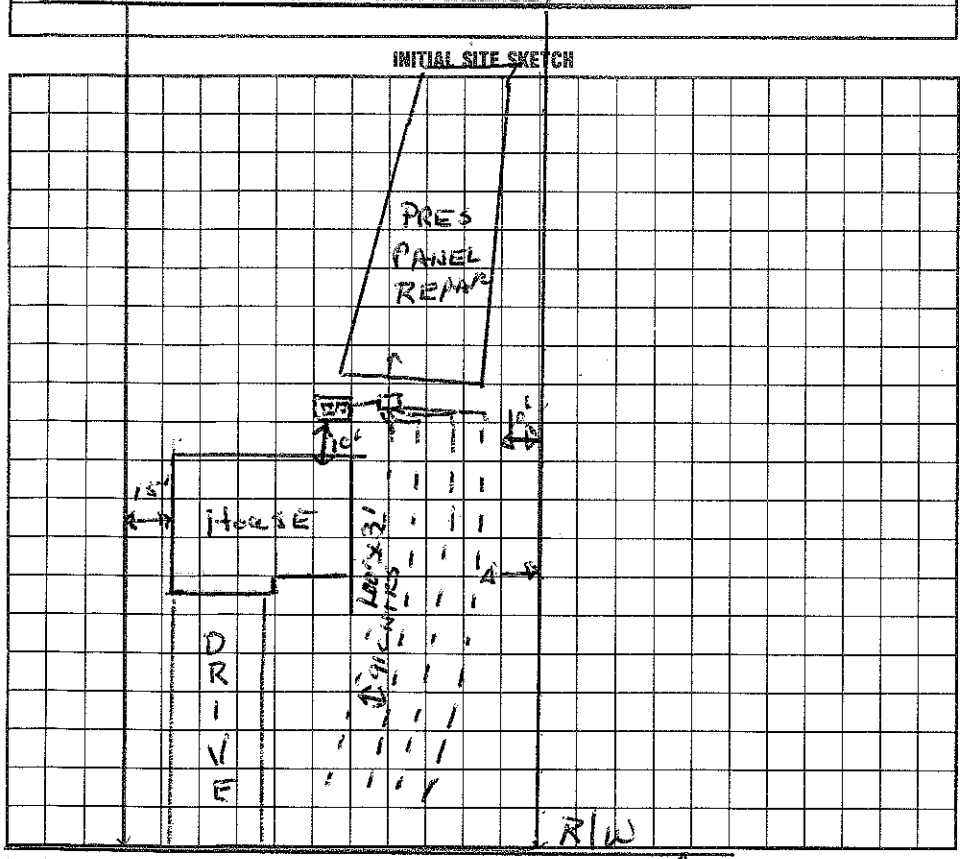

AS BUILT SKETCH

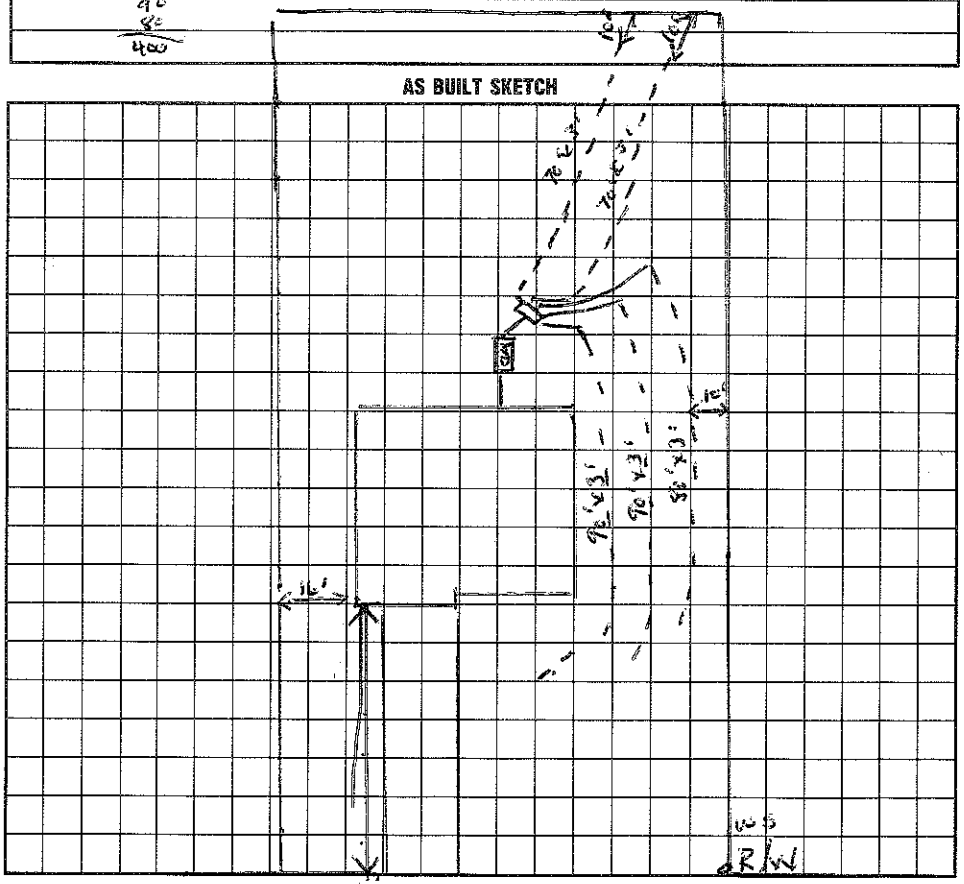

I understand that this permit can be suspended or revoked if any false information is supplied toward securing the permit/any unauthorized changes are made to the site/any unauthorized changes are made in the installation of the system. Improvement Permit is valid for 60 months from date of issuance.

Signed: _____

Improvement Permit by: Wesley Sparks R.S. date 9/14/94

Existing System Inspection by: _____ date _____

Installed by: Bob MacLeod

Certificate of Completion by: Wesley Sparks R.S. date 3/16/95

Operation Permit by: _____ date _____

HEALTH DEPT. COPY: WHITE INSPECTION COPY (FINAL): GREEN OWNER COPY (FINAL): YELLOW INSPECTION COPY (INITIAL): PINK OWNER COPY (INITIAL): GOLD