IREDELL COUNTY HEALTH DEPARTMENT

STATESVILLE 704-878-5305 PIN# 4655-55-5747 MOORESVILLE 704-664-5281

IMPROVEMENT PERMIT / CERTIFICATE OF COMPLETION / OPERATION PERMIT / EXISTING SYSTEM INSPECTION

PROPERTY DESCRIPTION NO. 18646 DATE 10/19/94 TAX MAP NO. 10-A-44 Pt of Watershed: ☐ Yes ☑ No

OWNER OR CONTRACTOR Bill Mott (English Hills) PHONE: Business 663-7660 Home

ADDRESS PO Box 1242 Mooresville, NC. 28115

LOCATION Faith Rd, TL on English Hills Dr. to 2nd lot (L)

SUBDIVISION English Hills BLOCK / SECTION 1 LOT 6 LOT AREA .56Ac SITE CLASS. P DESIGN FLOW 360 L.T.A.R. .35

Septic Tank: 1000 Gallons; STB 781 Date 3/17/95

Pump Tank: Gallons; PT Date

Pump Make: Model Serial No.

Nitrification Field: No Fields 1 Square Feet 1028 Linear Feet 342

No Lines 5 Trench Width 36" Max Trench Bottom Depth 32" Gravel Depth 12"

☑ New System ☐ Repair System Type: I, (II), III, IV, V, VI

System Description: Conv - Drop Box

Repair System Description:

Maintenance Agreement Required: ☐ Yes ☐ No

☐ House/Mod. Home ☐ Mobile Home ☐ Business ☐ Other

No. Bedrooms 3 No. Bathrooms 2 No. Employees


Water Supply: ☐ Individual ☐ Community ☐ Public

☐ Slab ☐ Crawl Space ☐ Basement w/plumbing ☐ Basement wo/plumbing

Comments: Difficult topography, no room for variation. Pressure system may be used as original system with original area as repair.

Comments:

INITIAL SITE SKETCH

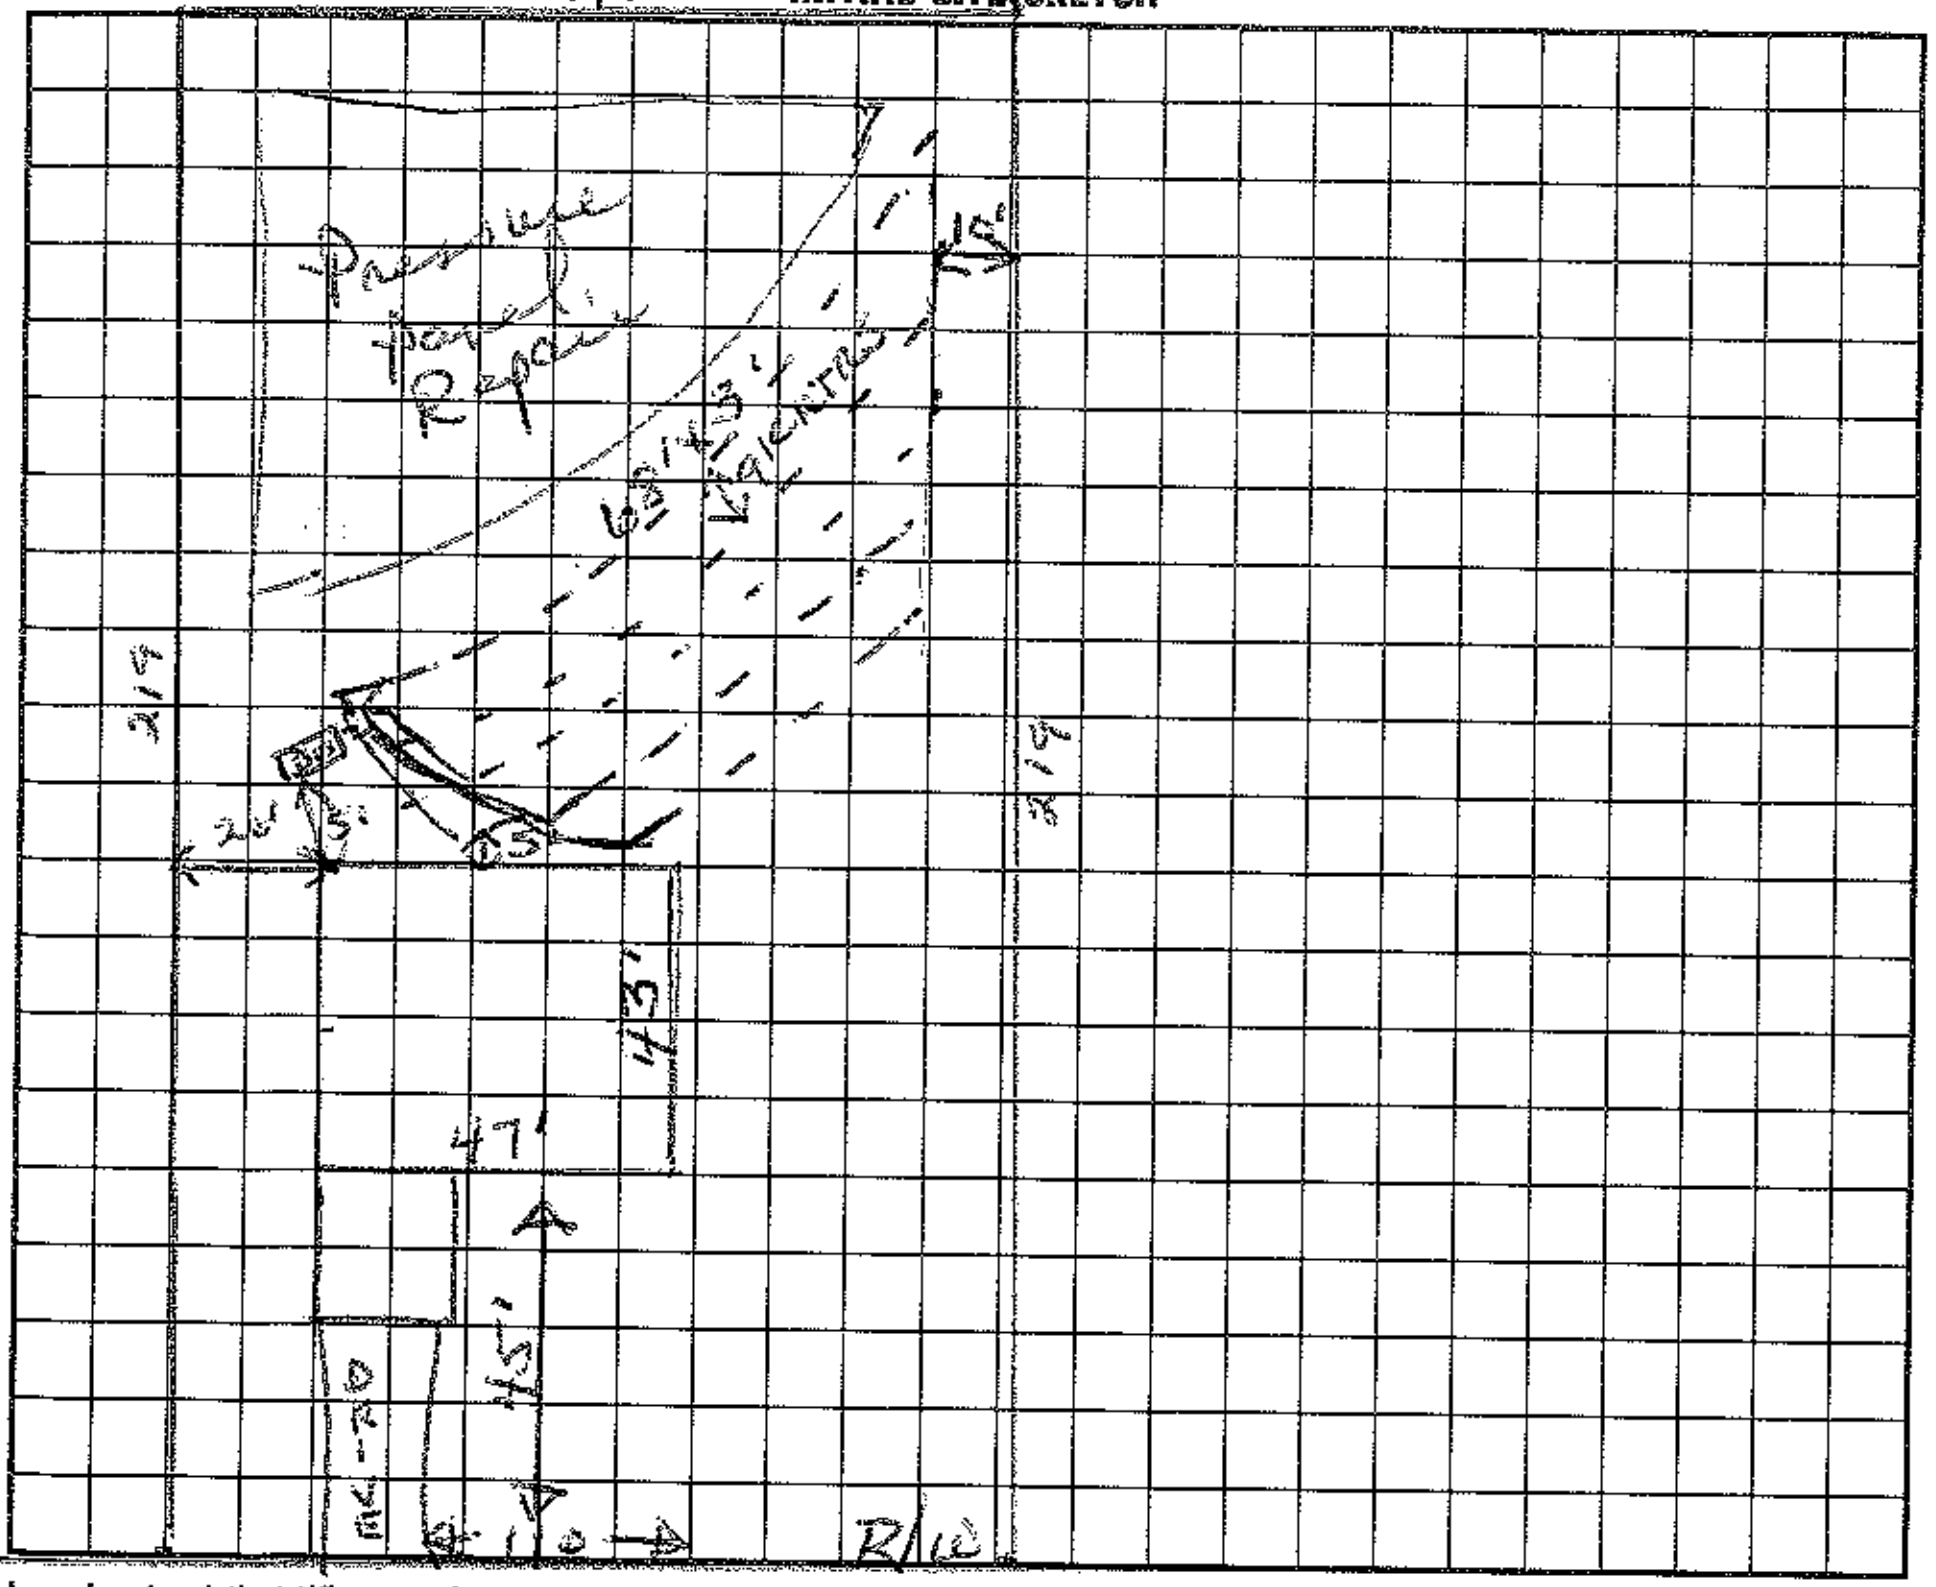

AS BUILT SKETCH

I understand that this permit can be suspended or revoked if any false information is supplied toward securing the permit/any unauthorized changes are made to the site/any unauthorized changes are made in the installation of the system. Improvement Permit is valid for 60 months from date of issuance.

Signed: x Paul Dunkel

Improvement Permit by: Wesley Sparks R.S. date 10/19/94

Existing System Inspection by: date

Installed by: ~~Rivers~~ Finger Landscaping

Certificate of Completion by: Wesley Sparks R.S. date 5/4/95

Operation Permit by: date

HEALTH DEPT. COPY: WHITE INSPECTION COPY (FINAL): GREEN OWNER COPY (FINAL): YELLOW INSPECTION COPY (INITIAL): PINK OWNER COPY (INITIAL): GOLD