PIN# 4655-55-6444

IREDELL COUNTY HEALTH DEPARTMENT

STATESVILLE 704-878-5305 MOORESVILLE 704-664-5281

IMPROVEMENT PERMIT / CERTIFICATE OF COMPLETION / OPERATION PERMIT / EXISTING SYSTEM INSPECTION

PROPERTY DESCRIPTION NO. 18641 DATE 6/16/94 TAX MAP NO. ID A44 Watershed: ☑ Yes ☐ No

OWNER OR CONTRACTOR BROAD MOOR HOMES PHONE: Business 663-7660 Home

ADDRESS PO BOX 1242 MOORESVILLE, NC. 28115

LOCATION FAITH RD. ON L JUST PAST MOTT RD.

SUBDIVISION ENGLISH HILLS BLOCK / SECTION 1 LOT 2 LOT AREA .87 AC SITE CLASS. P DESIGN FLOW 360 L.T.A.R. .3-.35

Septic Tank: 1000 Gallons; STB 825 Date 9/3/94

Pump Tank: Gallons; PT Date

Pump Make: Model Serial No.

Nitrification Field: No Fields 1 Square Feet 1020 Linear Feet 342

No Lines 4 Trench Width 3' Max Trench Bottom Depth 30" Gravel Depth 12"

☑ New System ☐ Repair System Type: I, (II), III, IV, V, VI

System Description: DROP BOX - CONV.

Repair System Description:

Maintenance Agreement Required: ☐ Yes ☑ No

☑ House/Mod. Home No. Bedrooms 3

☐ Mobile Home No. Bathrooms 2

☐ Business No. Employees

☐ Other


☐ Slab ☑ Crawl Space ☐ Basement w/plumbing ☐ Basement wo/plumbing

Water Supply: ☑ Individual ☐ Community ☐ Public

Comments: 80, 85, 85, 90 LINE LENGTHS

Comments: Installed as drawn on Imp Permit

INITIAL SITE SKETCH

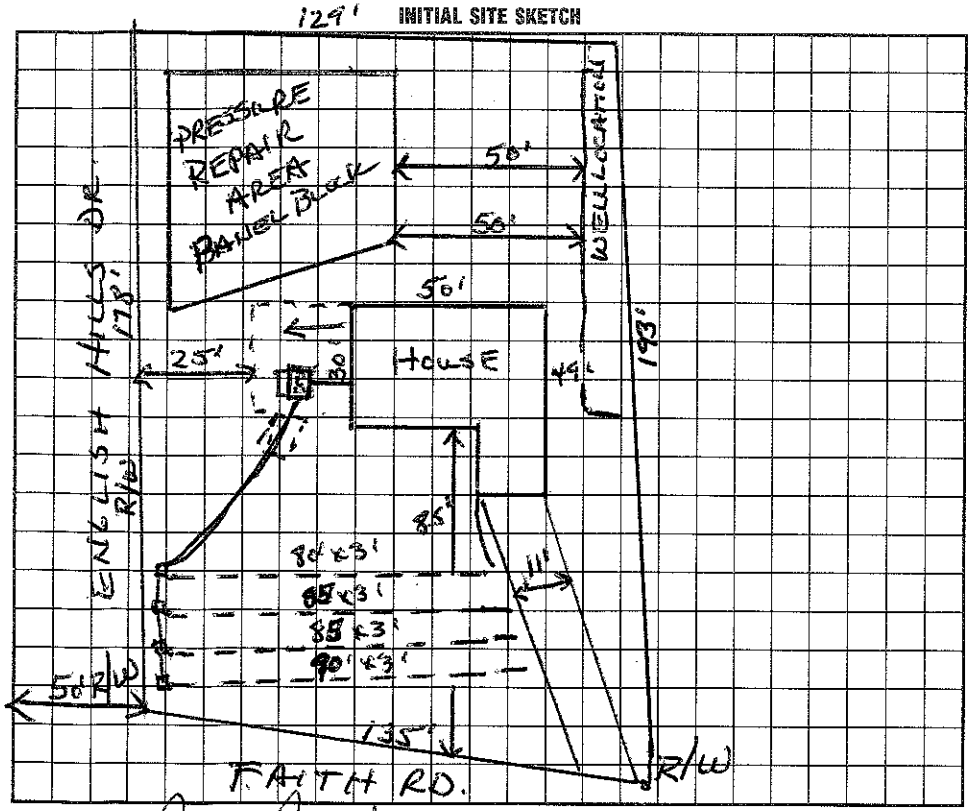

AS BUILT SKETCH

I understand that this permit can be suspended or revoked if any false information is supplied toward securing the permit/any unauthorized changes are made to the site/any unauthorized changes are made in the installation of the system. Improvement Permit is valid for 60 months from date of issuance.

Signed: David Broadwell

Improvement Permit by: Wesley Sparks RS. date 6/16/94

Existing System Inspection by: date

Installed by: Curt Dunning

Certificate of Completion by: Wesley Sparks RS. date 11/15/94

Operation Permit by: date

HEALTH DEPT. COPY: WHITE INSPECTION COPY (FINAL): GREEN OWNER COPY (FINAL): YELLOW INSPECTION COPY (INITIAL): PINK OWNER COPY (INITIAL): GOLD