PIN# 4655-55-6928

IREDELL COUNTY HEALTH DEPARTMENT

STATESVILLE 704-878-5305 MOORESVILLE 704-664-5281

IMPROVEMENT PERMIT / CERTIFICATE OF COMPLETION / OPERATION PERMIT / EXISTING SYSTEM INSPECTION

PROPERTY DESCRIPTION NO. 18648 DATE 3/27/94 TAX MAP NO. 1D-A-44 Watershed: ☐ Yes ☒ No

OWNER OR CONTRACTOR Bill Moff (English Hills) PHONE: Business 896-8789 Home

ADDRESS PO Box 213 Mt Mourne 28123

LOCATION Fourth Rd (L) on English Hills on (L) just past Woodhaven intersection

SUBDIVISION English Hills BLOCK / SECTION LOT 8 LOT AREA .56 ac SITE CLASS. P DESIGN FLOW 360 L.T.A.R. .35

Septic Tank: 1000 Gallons; STB 794 Date 9/11/95

Pump Tank: Gallons; PT Date

Pump Make: Model Serial No.

Nitrification Field: No Fields 1 Square Feet 1028 Linear Feet 1806

No Lines 4 Trench Width 24" Max Trench Bottom Depth 36" Gravel Depth 6" SAND

☒ New System ☐ Repair System Type: I, II, III, IV, V, VI

System Description: GRAVITY - PANEL

Repair System Description: SAME

Maintenance Agreement Required: ☐ Yes ☒ No

☒ House/Mod. Home No. Bedrooms 3

☐ Mobile Home No. Bathrooms 2

☐ Business No. Employees

☐ Other


☐ Slab ☒ Crawl Space ☐ Basement w/plumbing ☐ Basement wo/plumbing

Water Supply: ☒ Individual ☐ Community ☐ Public


Comments: * 16" Prefab. Panel Blocks

Comments:

INITIAL SITE SKETCH

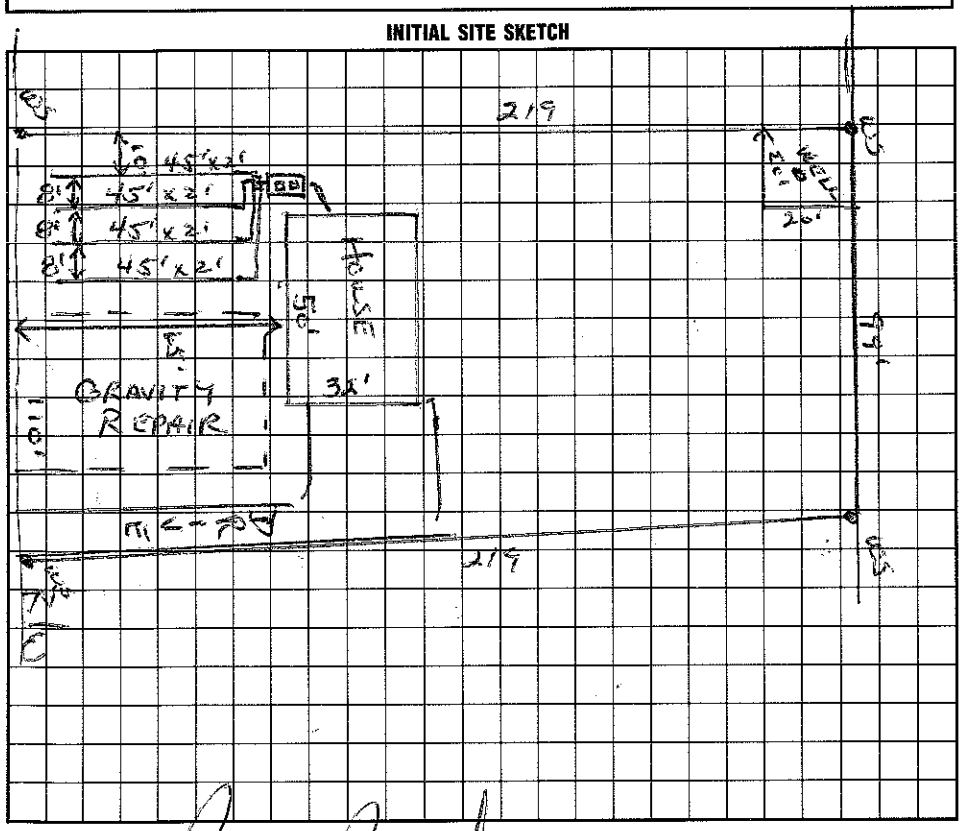

AS BUILT SKETCH

 

I understand that this permit can be suspended or revoked if any false information is supplied toward securing the permit/any unauthorized changes are made to the site/any unauthorized changes are made in the installation of the system. Improvement Permit is valid for 60 months from date of issuance.

Signed: X

Improvement Permit by: Wesley Sparks RS date 3/27/95

Existing System Inspection by: Wesley Sparks date 10/25/95

Installed by: Bob Mayhew

Certificate of Completion by: date

Operation Permit by: Wesley Sparks RS date 10/25/95

HEALTH DEPT. COPY: WHITE INSPECTION COPY (FINAL): GREEN OWNER COPY (FINAL): YELLOW INSPECTION COPY (INITIAL): PINK OWNER COPY (INITIAL): GOLD

ENGLISH HILLS DR.