PIN# 4655-55-7575

# IREDELL COUNTY HEALTH DEPARTMENT

STATESVILLE 704-878-5305 MOORESVILLE 704-664-5281

## IMPROVEMENT PERMIT / CERTIFICATE OF COMPLETION / OPERATION PERMIT / EXISTING SYSTEM INSPECTION

PROPERTY DESCRIPTION NO. 18674 DATE 8/11/94 TAX MAP NO. 1D A 44 Pt of. Watershed: ☐ Yes ☑ No

OWNER OR CONTRACTOR Broadmoor Homes PHONE: Business _____ Home 663-7660

ADDRESS PO Box 1242 Mooresville, NC. 28115

LOCATION Faith Rd. off 1153 TL on English Hills Dr. to 2nd Lot on (R)

SUBDIVISION English Hills BLOCK / SECTION 1 LOT 34 LOT AREA ~.84 AC SITE CLASS. P DESIGN FLOW 360 L.T.A.R. .3

Septic Tank: 1000 Gallons; STB 825 Date 11/11/94

Pump Tank: _____ Gallons; PT _____ Date _____

Pump Make: _____ Model — — Serial No. _____

Nitrification Field: No Fields 11 Square Feet 1200 Linear Feet 400

No Lines 3 Trench Width 36" Max Trench Bottom Depth 36" Gravel Depth 12"

☑ New System ☐ Repair System Type: I, II, III, IV, V, VI

System Description: Conc - Dist Box

Repair System Description: _____

Maintenance Agreement Required: ☐ Yes ☐ No

☑ House/Mod. Home No. Bedrooms 3

☐ Mobile Home No. Bathrooms 2

☐ Business No. Employees _____

☐ Other _____

☐ Slab ☑ Crawl Space ☐ Basement w/plumbing ☐ Basement wo/plumbing

Water Supply: ☑ Individual ☑ Community ☐ Public

Comments:

95' PWR


138 R/W

Trench depth 30"

Contour Important.

Comments:

INITIAL SITE SKETCH

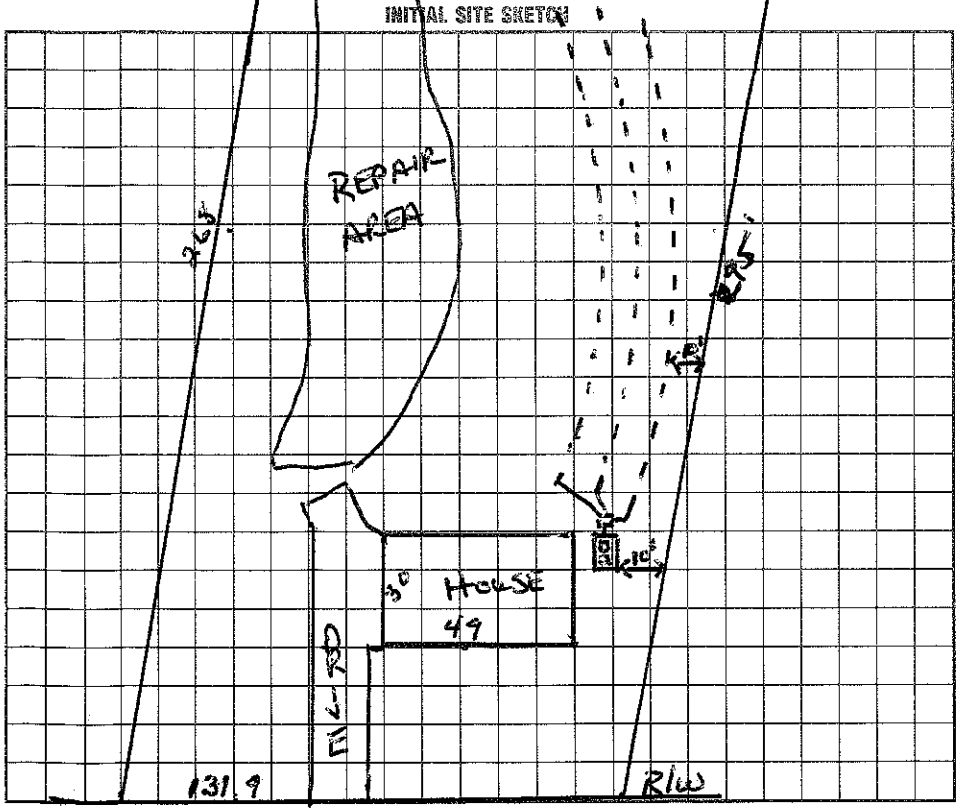


AS BUILT SKETCH

Installed as shown on Orig. Permit

I understand that this permit can be suspended or revoked if any false information is supplied toward securing the permit/any unauthorized changes are made to the site/any unauthorized changes are made in the installation of the system. Improvement Permit is valid for 60 months from date of issuance.

Signed: John W. Simmons

Improvement Permit by: Wesley Sparks R.S. date 8/11/94

Existing System Inspection by: _____ date _____

Installed by: Curt Dunning

Certificate of Completion by: Wesley Sparks R.S. date 1/5/95

Operation Permit by: _____ date _____

HEALTH DEPT. COPY: WHITE INSPECTION COPY (FINAL): GREEN OWNER COPY (FINAL): YELLOW INSPECTION COPY (INITIAL): PINK OWNER COPY (INITIAL): GOLD