PIN# 4655-55-8629

IREDELL COUNTY HEALTH DEPARTMENT

STATESVILLE 704-878-5305 MOORESVILLE 704-664-5281

IMPROVEMENT PERMIT / CERTIFICATE OF COMPLETION / OPERATION PERMIT / EXISTING SYSTEM INSPECTION

PROPERTY DESCRIPTION NO. 18673 DATE 8/8/94 TAX MAP NO. 10-A-114 Watershed: ☐ Yes ☒ No

OWNER OR CONTRACTOR Broadmoor Homes PHONE: Business 663-7660 Home

ADDRESS PO Box 1242 Mooresville

LOCATION Faith Rd. on (L) past Mott Rd TL Lot on (R) at first intersection

SUBDIVISION English Hills BLOCK / SECTION 2 LOT 33 LOT AREA .97 Ac SITE CLASS. P DESIGN FLOW 360 L.T.A.R. .3

Septic Tank: 1080 Gallons; STB 786 Date 1/24/95

Pump Tank: Gallons; PT Date

Pump Make: Model Serial No.

Nitrification Field: No Fields 1 Square Feet 1200 Linear Feet 400

No Lines 4 Trench Width 36" Max Trench Bottom Depth 32" Gravel Depth 12"

☒ New System ☐ Repair System Type: I, II, III, IV, V, VI

System Description: Conv.

Repair System Description: PANEL Block

Maintenance Agreement Required: ☐ Yes ☐ No

☒ House/Mod. Home No. Bedrooms 3

☐ Mobile Home No. Bathrooms 2

☐ Business No. Employees

☐ Other


☐ Slab ☒ Crawl Space ☐ Basement w/plumbing ☐ Basement wo/plumbing

Water Supply: ☐ Individual ☒ Community ☐ Public

Comments: 228 7/L

Comments:

INITIAL SITE SKETCH

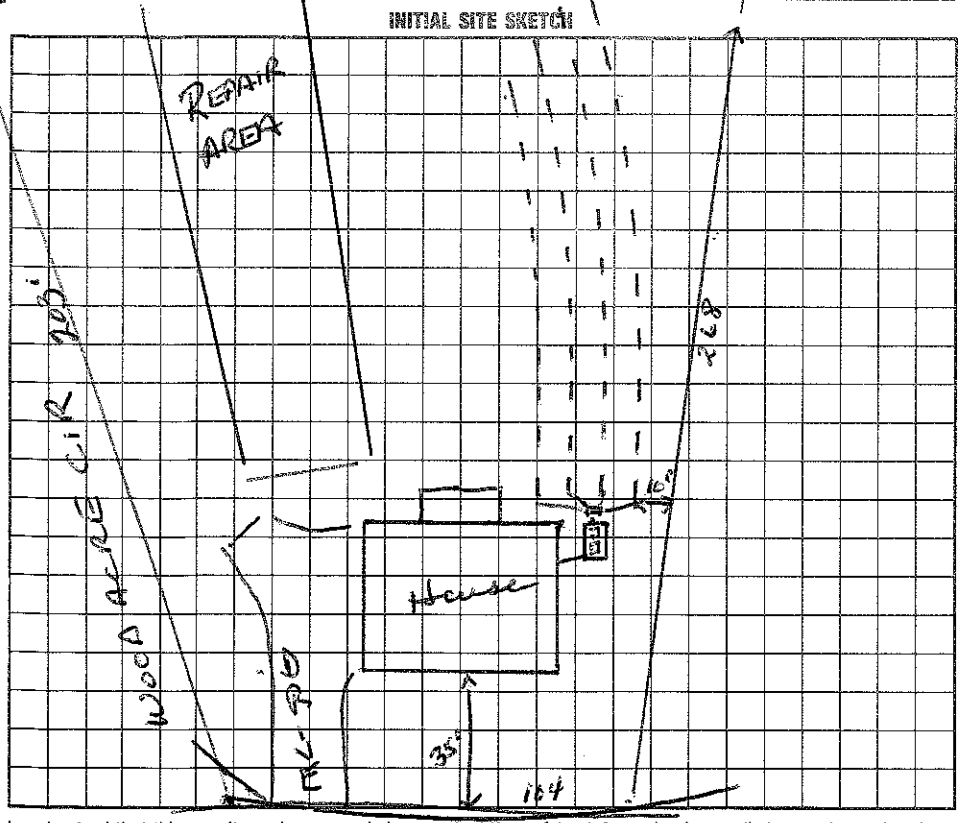

AS BUILT SKETCH

I understand that this permit can be suspended or revoked if any false information is supplied toward securing the permit/any unauthorized changes are made to the site/any unauthorized changes are made in the installation of the system. Improvement Permit is valid for 60 months from date of issuance.

Signed: X ENGLISH HILLS FOR Faith Rd.

Improvement Permit by: Wesley Sparks R.S. date 8/8/94

Existing System Inspection by: date

Installed by: ~~Rivers & Son~~ Finger Landscaping

Certificate of Completion by: Wesley Sparks R.S. date 5/4/95

Operation Permit by: date

HEALTH DEPT. COPY: WHITE INSPECTION COPY (FINAL): GREEN OWNER COPY (FINAL): YELLOW INSPECTION COPY (INITIAL): PINK OWNER COPY (INITIAL): GOLD