IREDELL COUNTY HEALTH DEPARTMENT

STATESVILLE 704-878-5305 MOORESVILLE 704-664-5281

IMPROVEMENT PERMIT / CERTIFICATE OF COMPLETION / OPERATION PERMIT / EXISTING SYSTEM INSPECTION

PROPERTY DESCRIPTION NO. 13649 DATE 10/19/94 TAX MAP NO. 10-A-44 Pt of Watershed: ☐ Yes ☐ No

OWNER OR CONTRACTOR Bill McFt (English Hills Dev.) PHONE: Business 663-7663 Home 1

ADDRESS PO Box 124 Mooresville, NC. 28115

LOCATION Woodacre Cir, Faith Rd (R) on Woodacre Rd. on (L) PIN # 4655-55-8982

SUBDIVISION English Hills BLOCK / SECTION 1 LOT 9 LOT AREA .95 Ac SITE CLASS. P DESIGN FLOW .360 L.T.A.R. .35

Septic Tank: 1000 Gallons; STB 785 Date 4/3/95

Pump Tank: _____ Gallons; PT _____ Date _____

Pump Make: _____ Model _____ Serial No. _____

Nitrification Field: No Fields 1 Square Feet 1024 Linear Feet 342

No Lines 3 Trench Width 36" Max Trench Bottom Depth 30" Gravel Depth 12"

☑ New System ☐ Repair System Type: I (II) III, IV, V, VI

System Description: CONV - DIST BOX

Repair System Description: _____

Maintenance Agreement Required: ☐ Yes ☑ No

☑ House/Mod. Home No. Bedrooms 3

☐ Mobile Home No. Bathrooms 2


☐ Business No. Employees _____

☐ Other _____

☐ Slab ☑ Crawl Space ☐ Basement w/plumbing ☐ Basement wo/plumbing

Water Supply:
☐ Individual
☐ Community
☐ Public

Comments:
Proposed
Garage
30'x30'

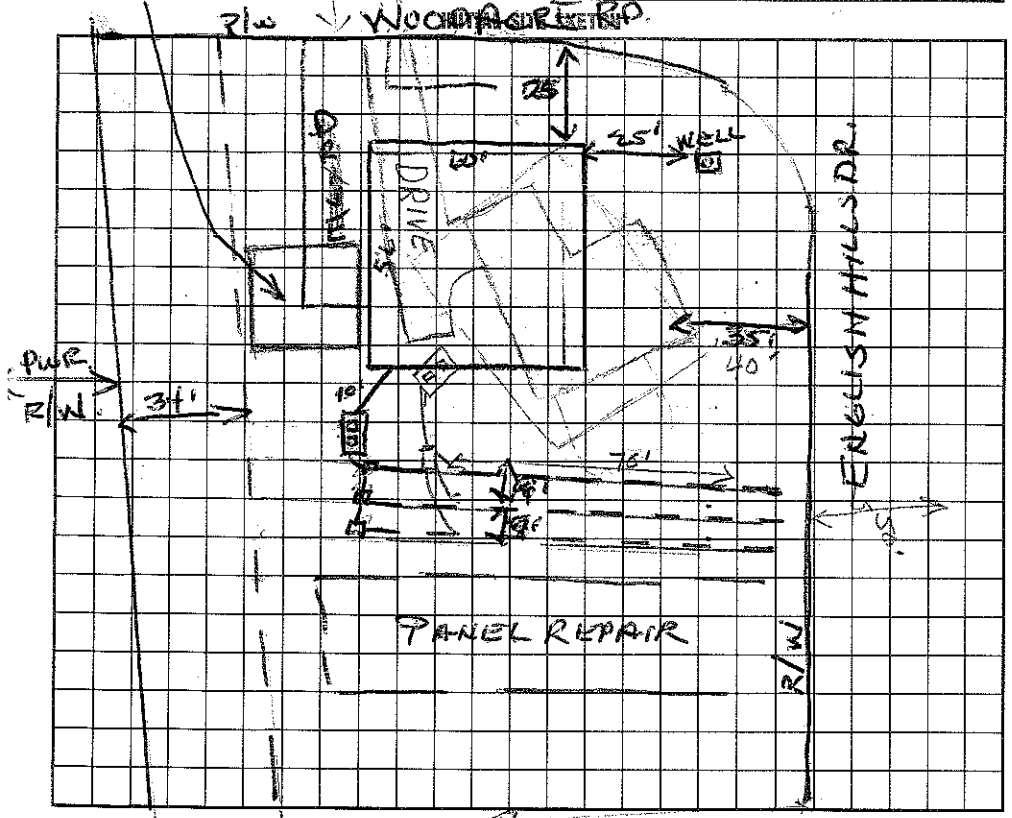

Comments:
install as shown in pencil

AS BUILT SKETCH

I understand that this permit can be suspended or revoked if any false information is supplied toward securing the permit/any unauthorized changes are made to the site/any unauthorized changes are made in the installation of the system. Improvement Permit is valid for 60 months from date of issuance.

Signed: _____

Improvement Permit by: Wesley Sparks RS. date 10/19/94

Existing System Inspection by: _____ date _____

Installed by: Finger Landscaping

Certificate of Completion by: Wesley Sparks RS date 6/15/95

Operation Permit by: _____ date _____

HEALTH DEPT. COPY: WHITE INSPECTION COPY (FINAL): GREEN OWNER COPY (FINAL): YELLOW INSPECTION COPY (INITIAL): PINK OWNER COPY (INITIAL): GOLD