IREDELL COUNTY HEALTH DEPARTMENT

9 AUTHORIZATION TO CONSTRUCT (3,00)

STATESVILLE 704-878-5305 MOORESVILLE 704-664-5281

IMPROVEMENT PERMIT / ~~CERTIFICATE OF COMPLETION~~ / OPERATION PERMIT / EXISTING SYSTEM INSPECTION

PROPERTY DESCRIPTION NO. 06 7788 DATE 7/21/97 TAX MAP NO. 4655560118 Watershed: ☒ ~~Yes~~ ☐ No

OWNER OR CONTRACTOR RICHARD M. BARNETTE PHONE: Business _____ Home 575-2445

ADDRESS 7300 BUD HENDERSON RD - HUNTERSVILLE NC 28078

LOCATION FAITH RD - TL JENNIE MARIE - TR JANI-WIND - AT END

SUBDIVISION SERENE LK BLOCK / SECTION - LOT 5 LOT AREA - SITE CLASS. P3 DESIGN FLOW 360 L.T.A.R. .3

Septic Tank: 1000 Gallons; STB 825 Date 7/24/98

Pump Tank: _____ Gallons; PT _____ Date _____

Pump Make: _____ Model _____ Serial No. _____

Nitrification Field: No Fields 1 Square Feet 1200 Linear Feet 400

No Lines 5@80' Trench Width 36" Max Trench Bottom Depth 36" Gravel Depth 12"

☑ New System ☐ Repair System Type: I (II) III, IV, V, VI

System Description: GRAVITY CONVENTIONAL

Repair System Description: SAME

Maintenance Agreement Required: ☐ Yes ☒ ~~No~~

☑ House/Mod. Home No. Bedrooms 3

☐ Mobile Home No. Bathrooms 2

☐ Business No. Employees _____

☐ Other _____


☐ Slab ☑ Crawl Space ☐ Basement w/plumbing ☐ Basement wo/plumbing

Water Supply:
☑ Individual
☐ Community
☐ Public

Comments:

Comments:

INITIAL SITE SKETCH 1"=100'

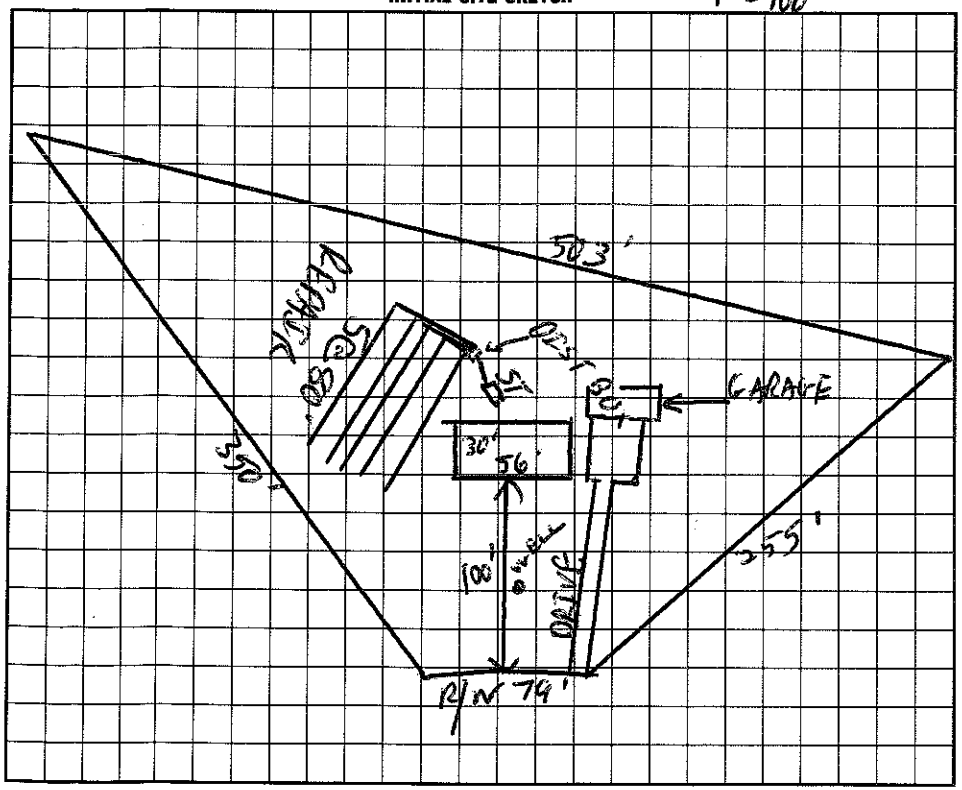

AS BUILT SKETCH

I understand that this permit can be suspended or revoked if any false information is supplied toward securing the permit/any unauthorized changes are made to the site/any unauthorized changes are made in the installation of the system. Improvement Permit is valid for 60 months from date of issuance.

Signed: Richard M Barnett

Installed by: PIEDMONT SEPTIC

Improvement Permit by: C. Rh Brown date 7/21/97

AUTH. TO CONSTRUCT

EXISTING System Inspection by: C. Rh Brown date 7/21/97

Certificate of Completion by: _____ date _____

Operation Permit by: C. Rh Brown date 10/14/98

HEALTH DEPT. COPY: WHITE INSPECTION COPY (FINAL): GREEN OWNER COPY (FINAL): YELLOW INSPECTION COPY (INITIAL): PINK OWNER COPY (INITIAL): GOLD