4655561907

IREDELL COUNTY HEALTH DEPARTMENT

STATESVILLE 704-878-5305 MOORESVILLE 704-664-5281

IMPROVEMENT PERMIT / CERTIFICATE OF COMPLETION / OPERATION PERMIT / EXISTING SYSTEM INSPECTION

PROPERTY DESCRIPTION NO. ~~ID-7-B-20~~ 16230 DATE JUNE 28, 1993 TAX MAP NO. ID-7-B-20

OWNER OR CONTRACTOR ELOISE HARDWICK PHONE: Business 704 875 6513 (216) Home 704 892 1201

ADDRESS RT 2 BOX 732 MOORESVILLE NC 28115

LOCATION ON NORTH SIDE OF FAITH ROAD 6/10 MILE EAST OF HWY 115 SOUTH OF MOORESVILLE, CUL DE SAC LOT, HARDWICK RD.

SUBDIVISION SERENE LAKE BLOCK / SECTION _____ LOT 20 LOT AREA 20,000 SITE CLASS. P L.T.A.R. 0.25 - 0.3

Water Supply: ☒ Individual ☐ Community ☐ Public INSTALLED 1-4-94

Septic Tank: 1000 Gallons; STB 794 Date 1-4-94

Pump Tank: NA Gallons; PT _____ Date _____

Nitrification Field: No Fields 1 Square Feet 960 Linear Feet 320

No Lines 4 Trench Width 36" Trench Depth 18" Gravel Depth 12"

☒ New System ☐ Repair System Type: I, II, IV, V, VI

System Description: GRAVITY CONVENTIONAL

Repair System Description: GRAVITY CONVENTIONAL

Maintenance Agreement Required: ☐ Yes ☒ No

☒ House/Mod. Home ☐ Mobile Home ☐ Business ☐ Other

No. Bedrooms 3 No. Bathrooms 3 No. Employees _____

☐ Slab ☐ Crawl Space ☒ Basement w/plumbing ☐ Basement wo/plumbing

Garbage Disposal: ☐ Yes ☒ No


Auto. Dishwasher: ☒ Yes ☐ No

Auto. Washing Machine: ☒ Yes ☐ No

Other _____


Comments *BASEMENT EXCAVATION CANNOT EXTEND INTO DRAINFIELD ~~AREA~~ OR WITHIN 15' OF IT. EXCAVATION SPOILS CANNOT ~~BE~~ SPREAD OVER DRAINFIELD AREA. DO NOT INSTALL DURING WET SOIL CONDITIONS OR RAIN. 2-4" OF LOAMY TOPSOIL MAY BE SPREAD OVER DRAINFIELD AFTER INSTALLATION - SEW WITH GRASS COVER CROP TO PREVENT EROSION.

INITIAL SITE SKETCH

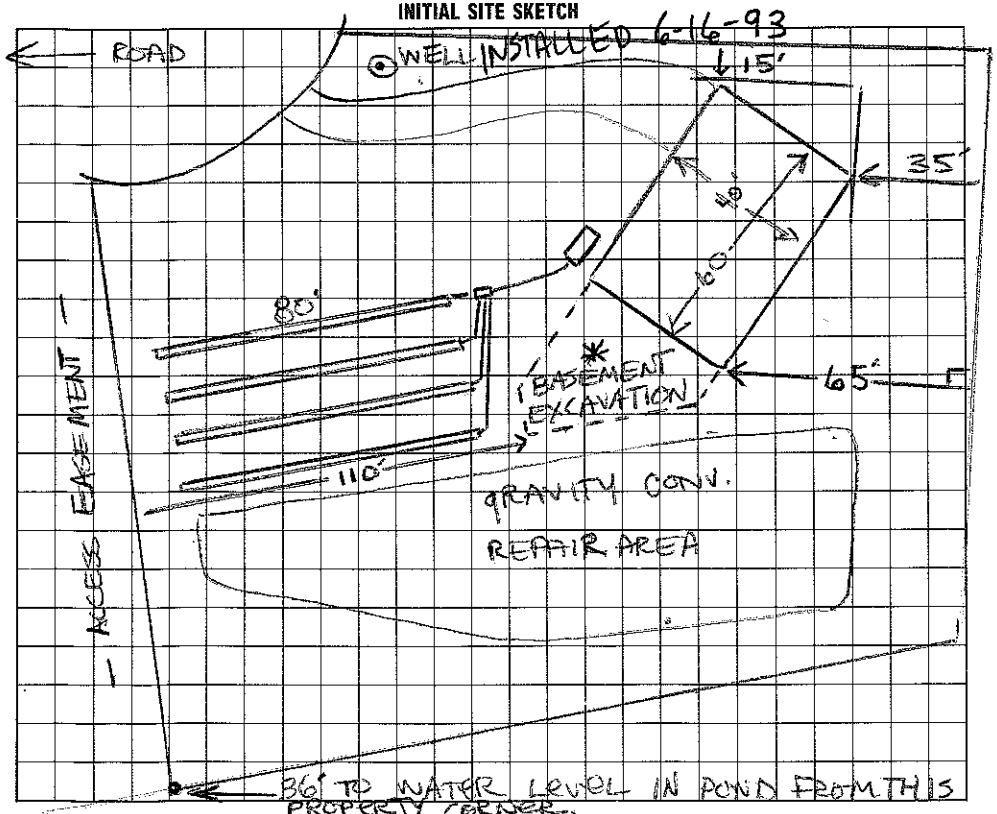

AS BUILT SKETCH

10-14-93 change in house location - downhill 12' so that sideline setback will be 27'. back line setback will remain 35' - Do not bring house forward. Plumbing stubout must be near the left end of the house to meet the tank location. Tank and system location and system design is not changed. Basement excavation cannot extend into repair area. Andrea Lemon

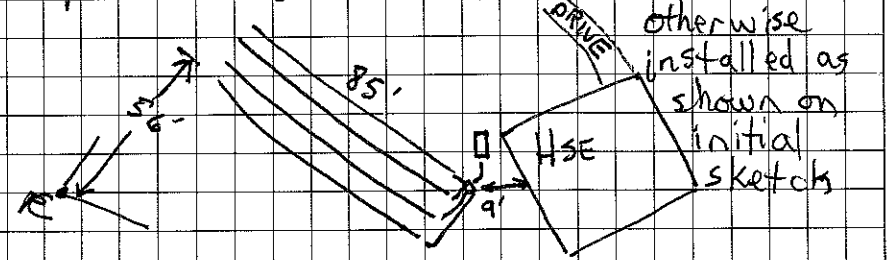

otherwise installed as shown on initial sketch

O. box in line w/ center post of double glass door well casing depth 80' dia. 6" tot depth 245' gravel interval 20' static water level 40 18 gpm

I understand that this permit can be suspended or revoked if any false information is supplied toward securing the permit/any unauthorized changes are made to the site/any unauthorized changes are made in the installation of the system. Improvement Permit is valid for 60 months from date of issuance.

Signed: Mitchell Blaine Hardwick

Improvement Permit by: Andrea Lemon date 6-28-93

Existing System Inspection by: _____ date _____

Installed by: Julian Bowles

Certificate of Completion by: Andrea Lemon date 4-26-94

Operation Permit by: _____ date _____

HEALTH DEPT. COPY: WHITE INSPECTION COPY (FINAL): GREEN OWNER COPY (FINAL): YELLOW INSPECTION COPY (INITIAL): PINK OWNER COPY (INITIAL): GOLD