# IREDELL COUNTY HEALTH DEPARTMENT

Statesville Office (704) 878-5305 Mooresville Office (704) 660-3625 PERMIT # 1130 208653

## IMPROVEMENT PERMIT / AUTHORIZATION TO CONSTRUCT / OPERATION PERMIT / EXISTING SYSTEM

PIN # 4655-56-5204.000

APPLICANT: RICHARD TUCKER APPLICANT ADDRESS: 116 MOTT RD. MOORESVILLE NC

SITE ADDRESS: 136 MOTT RD. MOORESVILLE NC PHONE: 704-201-5292 ALT. PHONE: —

SITE DIRECTIONS: HWY 115 TO FAITH RD., TL ONTO MOTT RD., 4TH HOUSE ON R.

SUBDIVISION: — SECTION: — LOT # — LOT AREA: 1.01 ACRE DESIGN FLOW: 360 GPD L.T.A.R.: EXISTING

| | | | | | | | | | |
|---|---|---|---|---|---|---|---|---|---|
| Septic Tank | 1000 (gal) | STB | 828 | Date | 1-19-15 | ☐ New System | ☒ Repair | ☐ Expansion | System Type: I (II) III IV V VI |
| Pump Tank | (gal) | PT | | Date | | System Description: | EXISTING | | |
| Pump Make | | Model | | Serial # | | Repair System Description: | | | |
| # Nitrification Fields | 1 | # Lines | EXISTING | Linear Ft: | EXISTING | Maintenance Agreement Required: | ☐ YES | ☒ NO | |
| Trench Width | EXISTING | Max. Trench Bottom Depth | EXISTING | Gravel Depth | EXISTING | | ☒ GRAVITY | ☐ PRESSURE | |

☒ Residence ☐ Business ☐ Other ☐ Slab ☐ Basement w/plumbing

No. Bedrooms 3 No. Persons 6 No. Employees — ☒ Crawl Space


Water Supply: ☒ Private ☐ Public ☐ Community

☐ Basement w/o plumbing


Comments / Conditions: EXISTING TANK CRACKED PER MOORE ENVIRONMENTAL. CRUSH AND FILL EXISTING TANK AND INSTALL NEW 1000 GAL TANK FOR SEPTIC RULES. HOOK BACK INTO EXISTING SEPTIC DRAINFIELD.

Note: Drain lines are clogged w/ concrete pipes for drainfield. Replaced beginning of lines with PVC 10' off of House with new ST.

INITIAL SITE SKETCH

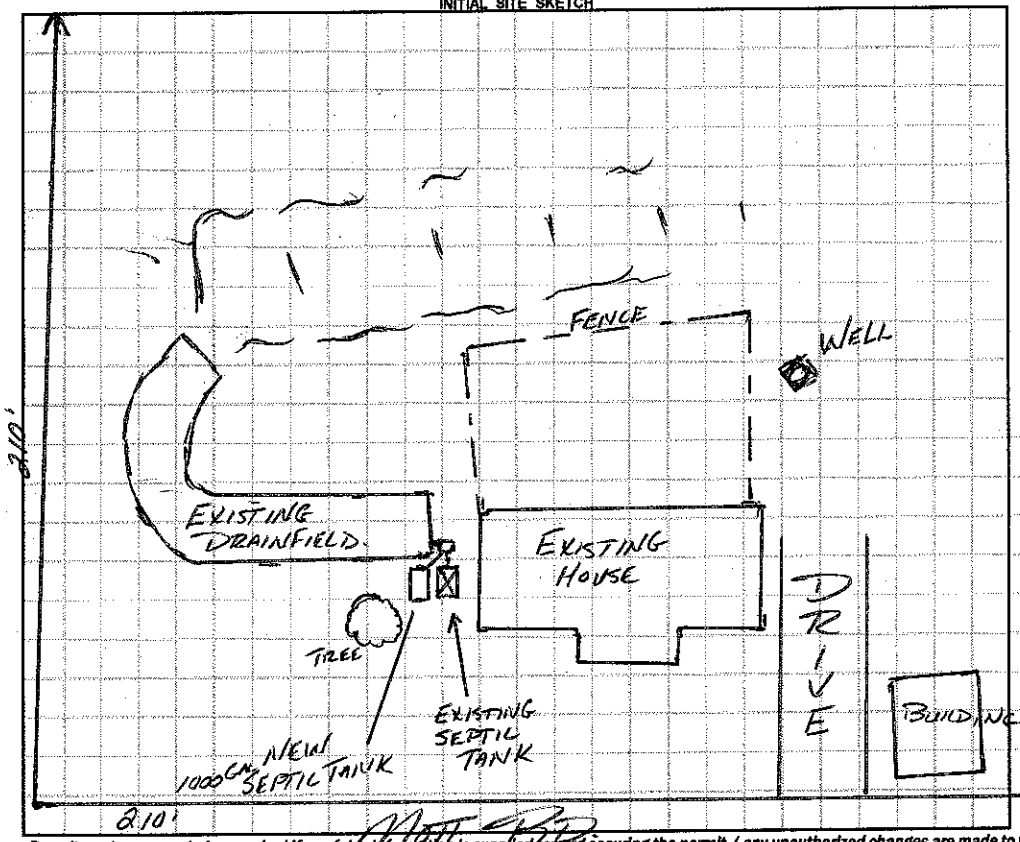


AS BUILT SKETCH

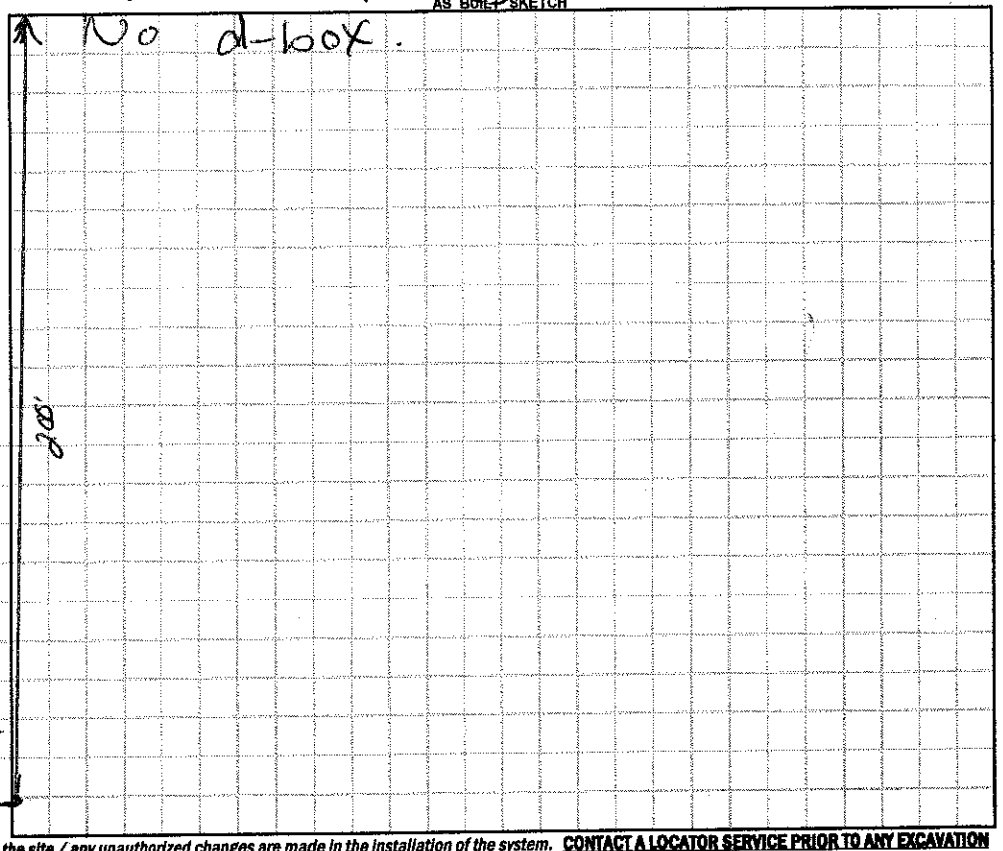


*Permit can be suspended or revoked if any false information is supplied toward securing the permit / any unauthorized changes are made to the site / any unauthorized changes are made in the installation of the system.* **CONTACT A LOCATOR SERVICE PRIOR TO ANY EXCAVATION**

☐ **IMPROVEMENT PERMIT** *with plat valid without expiration.* ☒ **IMPROVEMENT PERMIT** *with site plan valid for 60 mos.* ☒ **AUTHORIZATION TO CONSTRUCT** *valid for period equal to IMPROVEMENT PERMIT--not to exceed 60 mo.*

Owner / Applicant Signature: Richard Tucker Date: 3-3-15 Installed by: Randy Melton

IMPROVEMENT PERMIT by: APPROVED Date: MAR 03 2015 OPERATION PERMIT by: Mandy Dotson RS Date: 3/24/15

AUTHORIZATION TO CONSTRUCT by: APPROVED Date: MAR 03 2015 Existing System Inspected by: — Date: —

Health Dept. Copy - WHITE Applicant (Final Approval) - YELLOW Applicant (Conditional Approval) - PINK

Installers
Plan 2

75 Chambers IQ4W
300 Linear Ft

