IREDELL COUNTY HEALTH DEPARTMENT

Statesville Office (704) 878-5305 Mooresville Office (704) 660-3625 PERMIT # 209257

DSE 2:00 2:00

IMPROVEMENT PERMIT / AUTHORIZATION TO CONSTRUCT / OPERATION PERMIT / EXISTING SYSTEM

PIN # 4655-56-5204

APPLICANT: RICHARD TUCKER APPLICANT ADDRESS: 116 MOTT RD.

SITE ADDRESS: 136 MOTT RD. PHONE: 704-201-5292 ALT. PHONE:

SITE DIRECTIONS: FAITH, TL MOTT, ON R

SUBDIVISION: SECTION: LOT # LOT AREA: 1.01 AC DESIGN FLOW: 360 L.T.A.R.: .35

Septic Tank EXISTING (gal) STB Date

Pump Tank (gal) PT Date

Pump Make Model Serial #

Nitrification Fields 1 # Lines 5E52' Linear Ft: 260'

Trench Width 36" Max. Trench Bottom Depth 36" Gravel Depth —

☐ New System ☒ Repair ☐ Expansion System Type: I II (III) IV V VI

System Description:

Repair System Description: 25% REDUCTION

Maintenance Agreement Required: ☐ YES ☒ NO

☒ GRAVITY ☐ PRESSURE


☒ Residence ☐ Business ☐ Other ☐ Slab ☐ Basement w/plumbing

No. Bedrooms 3 No. Persons No. Employees ☒ Crawl Space ☐ Basement w/o plumbing


Water Supply: ☒ Private ☐ Public ☐ Community

Comments / Conditions:

INITIAL SITE SKETCH

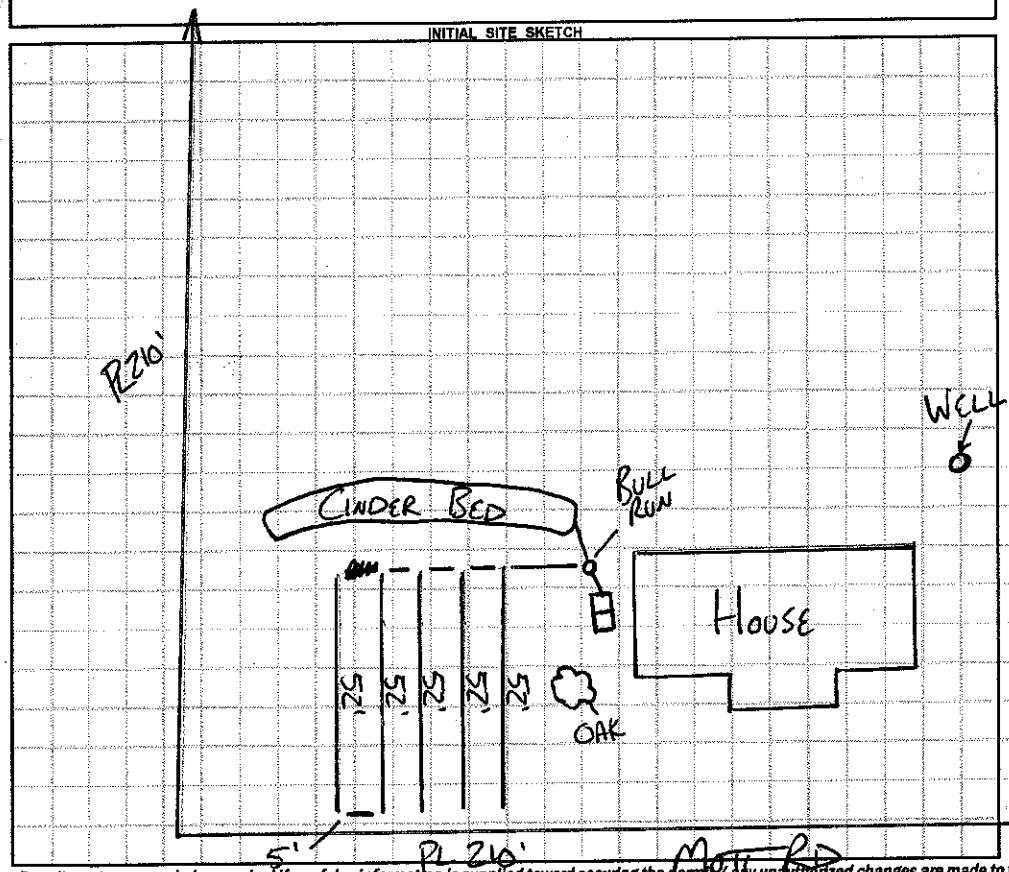

AS BUILT SKETCH

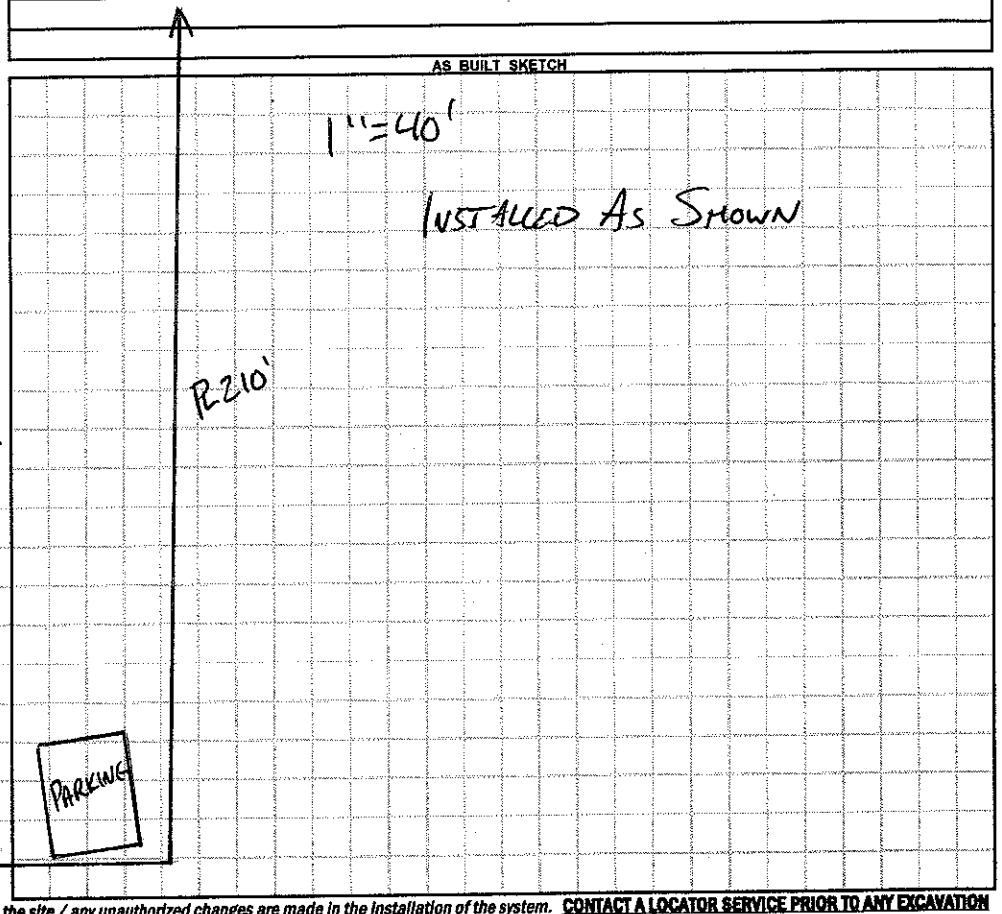

Permit can be suspended or revoked if any false information is supplied toward securing the permit / any unauthorized changes are made to the site / any unauthorized changes are made in the installation of the system. **CONTACT A LOCATOR SERVICE PRIOR TO ANY EXCAVATION**

☐ **IMPROVEMENT PERMIT** *with plat valid without expiration.* ☒ **IMPROVEMENT PERMIT** *with site plan valid for 60 mos.* ☒ **AUTHORIZATION TO CONSTRUCT** *valid for period equal to IMPROVEMENT PERMIT--not to exceed 60 mo.*

Owner / Applicant Signature: Richard Tucker Date: 5-2-15 Installed by: RANDY MELTON

IMPROVEMENT PERMIT by: APPROVED MAY 06 2015 Date: OPERATION PERMIT by: APPROVED MAY 26 2015 Date:

AUTHORIZATION TO CONSTRUCT by: APPROVED MAY 06 2015 Date: Existing System Inspected by: Date:

Health Dept. Copy - WHITE Applicant (Final Approval) - YELLOW Applicant (Conditional Approval) - PINK