IREDELL COUNTY HEALTH DEPARTMENT

→ Authorization To Construct

4655595588

STATESVILLE 704-878-5305 MOORESVILLE 704-664-5281

IMPROVEMENT PERMIT / ~~CERTIFICATE OF COMPLETION~~ / OPERATION PERMIT / EXISTING SYSTEM INSPECTION

PROPERTY DESCRIPTION NO. 2276O DATE 4/9/96 TAX MAP NO. 10-2-4-16 Watershed: ☐ Yes ☑ No

OWNER OR CONTRACTOR Joyce S Wright PHONE: Business _____ Home 664-2762

ADDRESS 184 Saddle Rd.

LOCATION Mackwood Rd - TR Saddle Rd - ~~#~~ 184

SUBDIVISION Archie Miller BLOCK / SECTION _____ LOT 16 LOT AREA 1ac SITE CLASS. BS DESIGN FLOW 270gpd T.A.R. _____

Septic Tank: 1600 Gallons; STB _____ Date _____

Pump Tank: _____ Gallons; PT _____ Date _____

Pump Make: _____ Model _____ Serial No. _____

Nitrification Field: No Fields ____ Square Feet _____ Linear Feet _____

No Lines _____ Trench Width _____ Max Trench Bottom Depth _____ Gravel Depth _____

☐ New System ☐ Repair System Type: I, II, III, IV, V, VI

System Description: Gravity Conventional

Repair System Description: _____

Maintenance Agreement Required: ☐ Yes ☑ No

☑ House/Mod. Home No. Bedrooms 2

☐ Mobile Home No. Bathrooms 1

☐ Business No. Employees ____

☐ Other _____

☐ Slab ☐ Crawl Space ☐ Basement w/plumbing ☑ Basement wo/plumbing


Water Supply: ☑ Individual ☐ Community ☐ Public

Comments: Only 16 additional feet may be added to the side of the house. Keep addition 5' from any part of septic system.


Comments:

Bobby Lee Ln

INITIAL SITE SKETCH

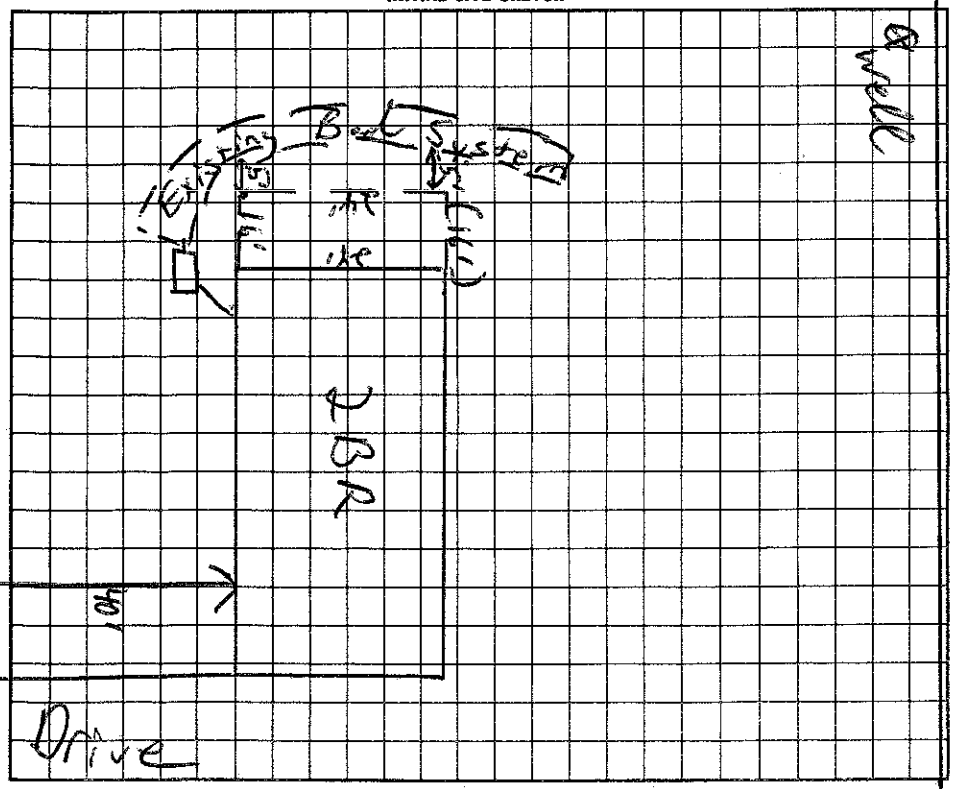

AS BUILT SKETCH

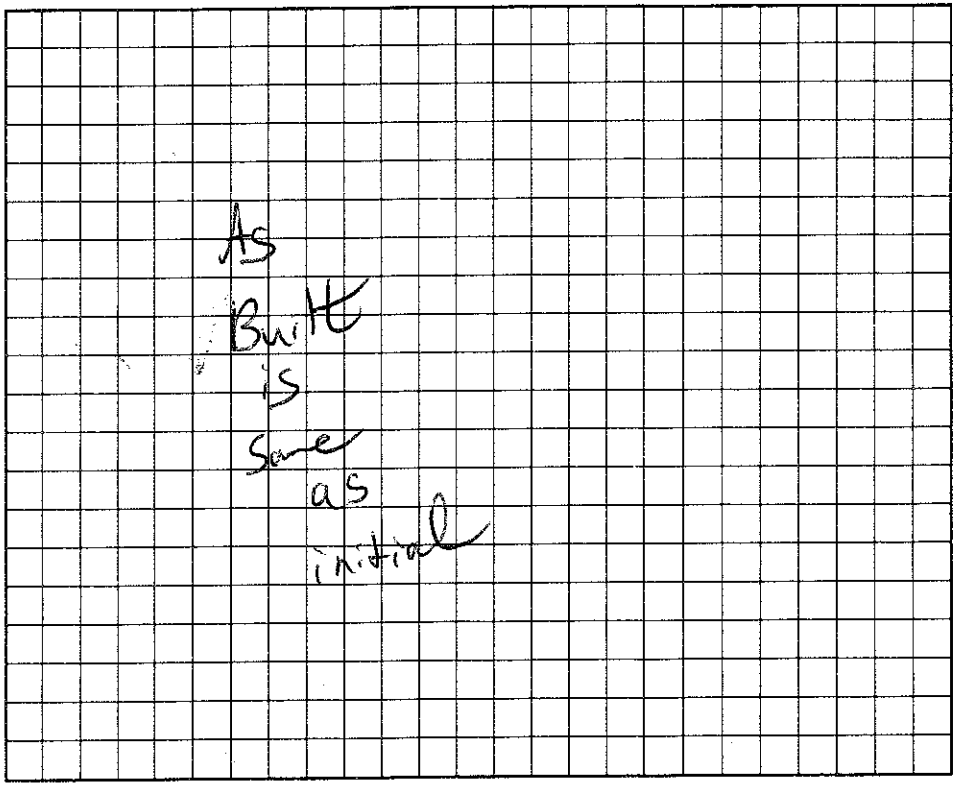

I understand that this permit can be suspended or revoked if any false information is supplied toward securing the permit/any unauthorized changes are made to the site/any unauthorized changes are made in the installation of the system.

Signed: Joyce S. Wright

Installed by: _____

Improvement Permit by: _____ date _____

Certificate of Completion by: _____ date _____

Existing System Inspection by: C. Brady Freeman EHSI date 4/9/96

Operation Permit by: C. Brady Freeman EHSI date 4/9/96

HEALTH DEPT. COPY: WHITE INSPECTION COPY (FINAL): GREEN OWNER COPY (FINAL): YELLOW INSPECTION COPY (INITIAL): PINK OWNER COPY (INITIAL): GOLD