IREDELL COUNTY HEALTH DEPARTMENT

STATESVILLE 704-878-5305 130.00 Paid MOORESVILLE 704-664-5281

11:36

IMPROVEMENT PERMIT / AUTHORIZATION TO CONSTRUCT / OPERATION PERMIT / EXISTING SYSTEM INSPECTION

PERMIT# 105348 PIN# 4655 50 7550 4655600821 DATE 4/9/02

OWNER OR CONTRACTOR Clay Stone PHONE: Business Home 704-896-7205

ADDRESS Midway Lake Rd. Mt. Mourne, NC 28123

LOCATION 115-215' TL Midway Lake on (R) before #365

SUBDIVISION No BLOCK / SECTION LOT LOT AREA 20,000 Ft² SITE CLASS PS DESIGN FLOW 360 L.T.A.R. .82

Septic Tank: 1000 Gallons; STB Date 3/4/02

Pump Tank: Gallons; PT Date

Pump Make: Model Serial No.

Nitrification Field: No Fields 2 Square Feet 1440 Linear Feet 480

No Lines 8@60' Trench Width 3' Max Trench Bottom Depth 32" Gravel Depth 12"

☒ New System ☐ Repair System Type: I, II, III, IV, V, VI, P/C

System Description: Conventional

Repair System Description: Same

Maintenance Agreement Required: ☐ Yes ☐ No

☒ House/Mod. Home No. Bedrooms 3

☐ Mobile Home No. Bathrooms 2

☐ Business No. Employees

☐ Other


☐ Slab ☐ Crawl Space ☐ Basement w/plumbing ☐ Basement wo/plumbing

Water Supply: ☒ Individual ☐ Public ☐ Community

Comments/Conditions:

INITIAL SITE SKETCH

(1" = 50')

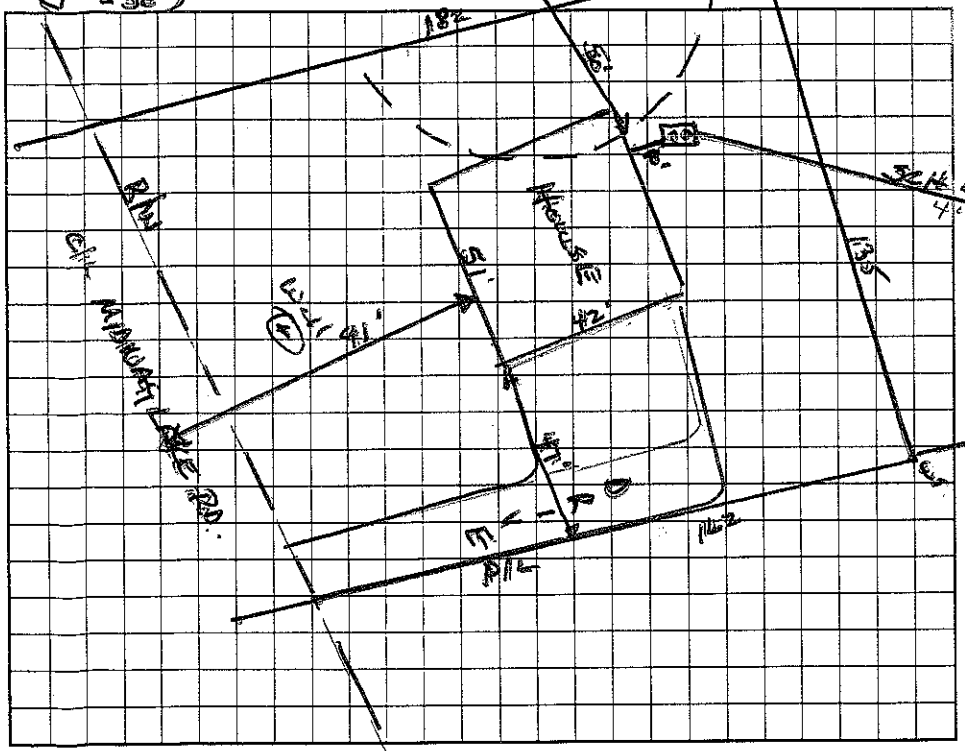


Comments:/Conditions:

FENCE

BARN

AS BUILT SKETCH

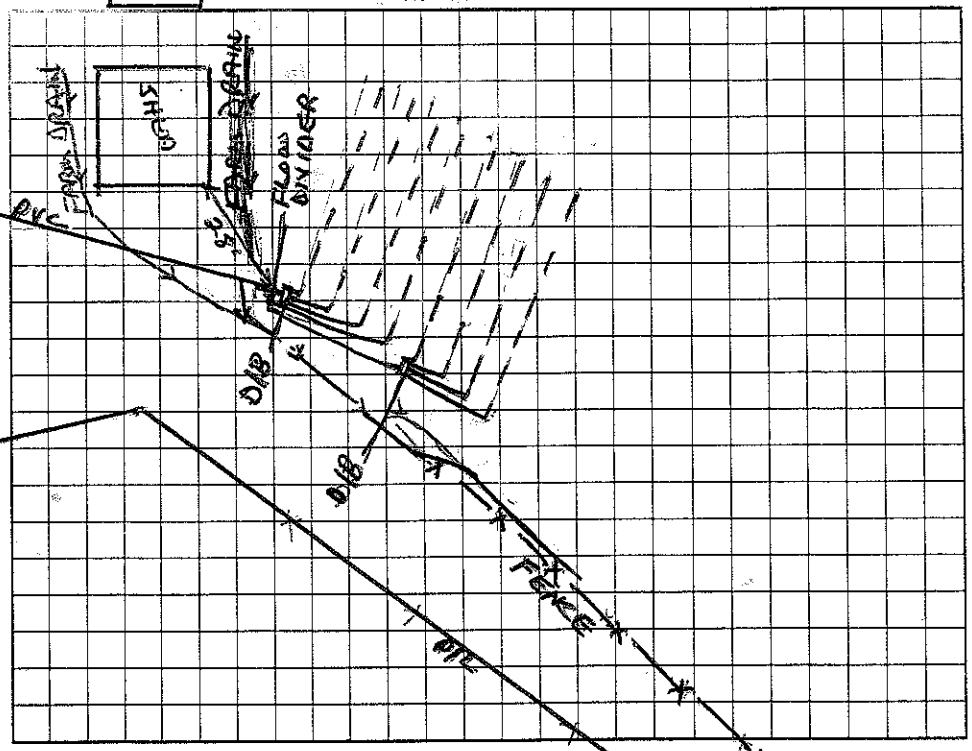

Permit can be suspended or revoked if any false information is supplied toward securing the permit/any unauthorized changes are made to the site/any unauthorized changes are made in the installation of the system. Improvement Permit with plat valid without expiration. Improvement Permit with site plan valid for sixty months. Authorization to Construct is valid for a period equal to that of Improvement Permit – not to exceed sixty months.

Signed: Sherman C. Stone date 4-9-02 Installed by: A-1 Backhoe

Improvement Permit by: Wesley Sparks RS. date 4/9/02 Operation Permit by: Wesley Sparks RS date 7/29/02

Authorization to Construct by: Wesley Sparks RS. date 4/9/02 Existing System Inspection by: date

HEALTH DEPT. COPY: WHITE OWNER COPY (FINAL): YELLOW OWNER COPY (INITIAL): PINK