IREDELL COUNTY HEALTH DEPARTMENT

STATESVILLE 704-878-5305 MOORESVILLE 704-664-5281

IMPROVEMENT PERMIT / CERTIFICATE OF COMPLETION / OPERATION PERMIT / EXISTING SYSTEM INSPECTION

PROPERTY DESCRIPTION NO. 20073 DATE 2/8/95 TAX MAP NO. 1C 9 A 2 4655-60-3803 Watershed: ☐ Yes ☑ No

OWNER OR CONTRACTOR Spears Const. Co. PHONE: Business _____ Home _____

ADDRESS 607 Anderson St. Salisbury NC.

LOCATION Berachah Place (R) off Midway Lake Rd. 3rd lot on (R)

SUBDIVISION Berachah Pl. BLOCK / SECTION _____ LOT 2 LOT AREA 2.197 Ac SITE CLASS. P DESIGN FLOW 360 L.T.A.R. .3

Septic Tank: 1000 Gallons; STB 825 Date 4/21/95

Pump Tank: 1000 Gallons; PT 47 Date 5/1/95

Pump Make: _____ Model _____ Serial No. _____

Nitrification Field: No Fields 1 Square Feet 1200 Linear Feet 400

No Lines 4 Trench Width 36" Max Trench Bottom Depth 36" Gravel Depth 12"

☑ New System ☐ Repair System Type: I, II, III, IV, V, VI,

System Description: Pressure Conventional

Repair System Description: _____

Maintenance Agreement Required: ☐ Yes ☑ No

☑ House/Mod. Home No. Bedrooms 3

☐ Mobile Home No. Bathrooms 2

☐ Business No. Employees _____

☐ Other _____

☐ Slab ☑ Crawl Space ☐ Basement w/plumbing ☐ Basement wo/plumbing

Water Supply: ☑ Individual ☐ Community ☐ Public

Comments:

240 400

(7) Travel .66 .01

1440 2400


1440 000

158.40 2400


Comments:

6/26/95 Phone con - changed to Pump 0/B with gate valve to Drop Box

INITIAL SITE SKETCH

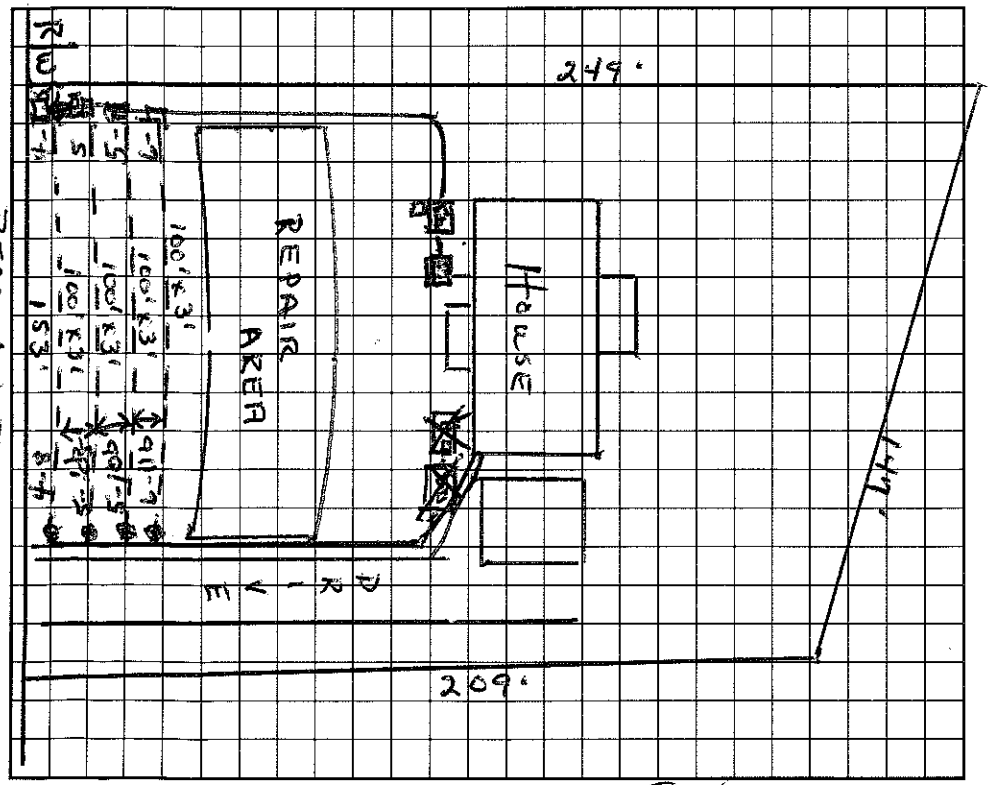

AS BUILT SKETCH

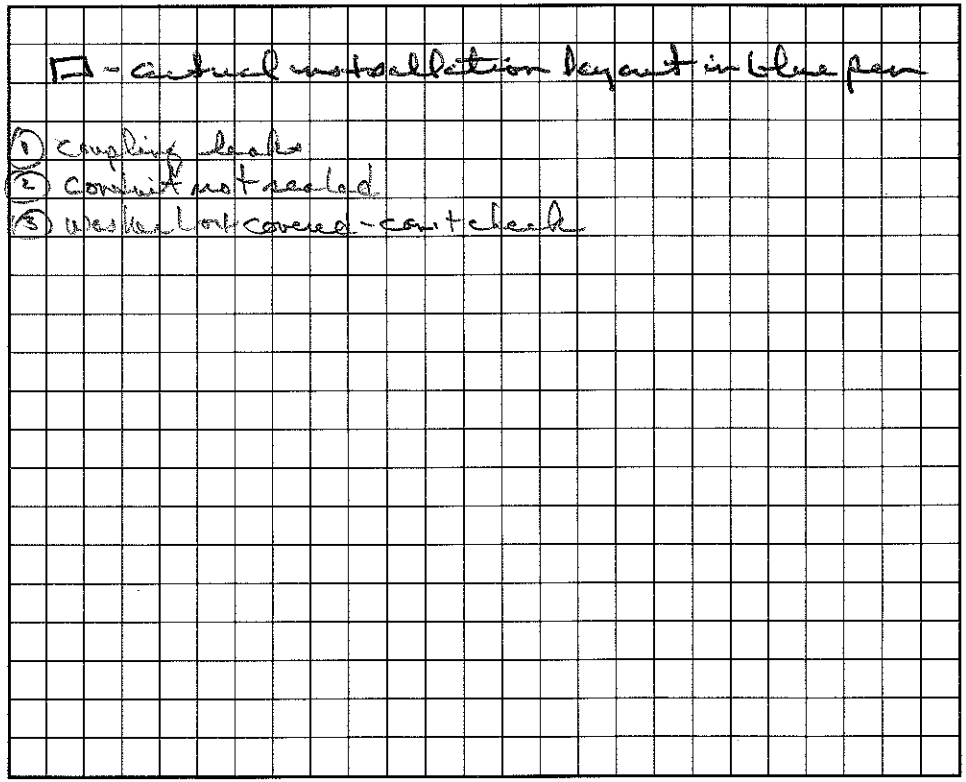

I understand that this permit can be suspended or revoked if any false information is supplied toward securing the permit/any unauthorized changes are made to the site/any unauthorized changes are made in the installation of the system. Improvement Permit is valid for 60 months from date of issuance.

Signed: _____

Improvement Permit by: Wesley Sparks R.S. date 2/8/95

Existing System Inspection by: _____ date _____

Installed by: Rowen Septic Tank

Certificate of Completion by: Wesley Sparks R.S. date 6/28/95

Operation Permit by: _____ date _____

HEALTH DEPT. COPY: WHITE INSPECTION COPY (FINAL): GREEN OWNER COPY (FINAL): YELLOW INSPECTION COPY (INITIAL): PINK OWNER COPY (INITIAL): GOLD