IREDELL COUNTY HEALTH DEPARTMENT

STATESVILLE 704-878-5305 MOORESVILLE 704-664-5281

IMPROVEMENT PERMIT / AUTHORIZATION TO CONSTRUCT / OPERATION PERMIT / EXISTING SYSTEM INSPECTION

PERMIT # 154492 PIN # 4655605927 DATE 1-23-09

OWNER or APPLICANT JZ Custom Home Additions/Margaret Campbell PHONE: Business JTII-704902-4844 Home:

OWNER or APPLICANT ADDRESS 135 Hightower Ct. Mooresville, NC 28117

LOCATION / DIRECTIONS Hwy 115 South TL Midway Lake TR Beracah Rd house on left

SUBDIVISION Beracah Place BLOCK / SECTION LOT # 25 LOT AREA .94Acre DESIGN FLOW 360gpd L.T.A.R.

Exist

Septic Tank 1000 Gallons: STB Date

Pump Tank Gallons: P T Date

Pump Make Model Serial #

Exist Nitrification Field No Fields 1 No Lines 5 Linear Feet 450'

Trench Width 36" Max. Trench Bottom Depth 24"-36" Gravel Depth 12"

☐ New System ☐ Repair ☐ Expansion System Type I (II) III IV V VI

System Description: Existing Gravity - Conventional

Repair System Description: Grav/Pump - 25% Red.

Maintenance Agreement Required ☐ YES ☐ NO

☒ GRAVITY ☐ PRESSURE

☒ Residence No. Bedrooms 3

☐ Business No. Persons

☐ Other No. Employees

☐ Slab ☐ Crawl Space


☐ Basement w/plumbing ☐ Basement w/o plumbing

Water Supply: ☒ Private ☐ Public ☐ Community

Comments / Conditions Scale 1:50


Beracah

INITIAL SITE SKETCH

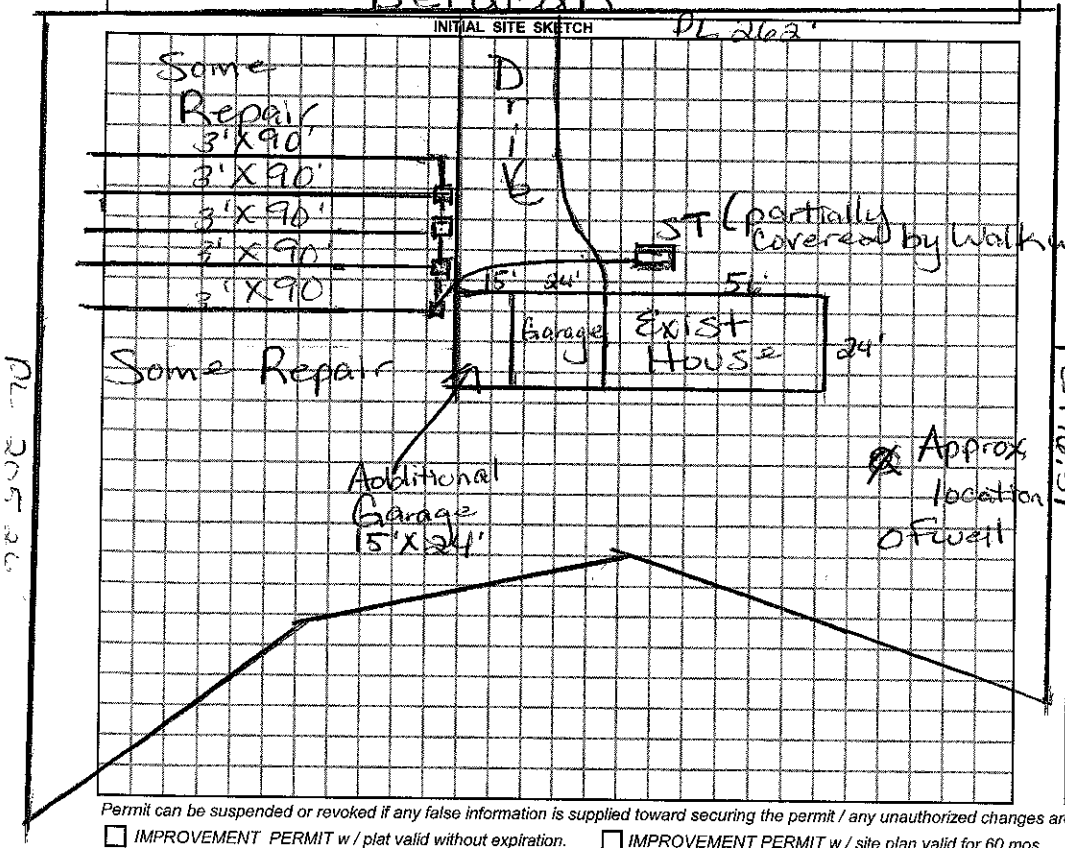

Comments / Conditions ☒ Existing Septic System appears to be functioning Okay at time of inspection. 5Ft setback between addition & Septic System. Addition should not have any substantial impact on Septic System.

AS BUILT SKETCH

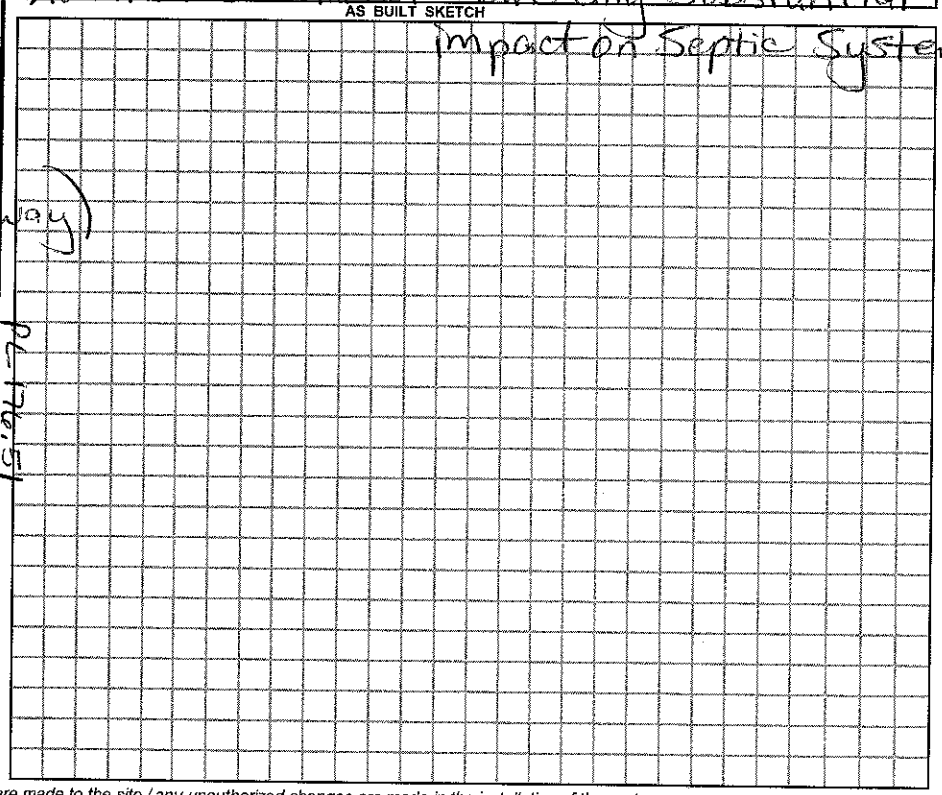

Permit can be suspended or revoked if any false information is supplied toward securing the permit / any unauthorized changes are made to the site / any unauthorized changes are made in the installation of the system.

☐ *IMPROVEMENT PERMIT w / plat valid without expiration.* ☐ *IMPROVEMENT PERMIT w / site plan valid for 60 mos.* ☐ *AUTHORIZATION TO CONSTRUCT valid for period equal to IMPROVEMENT PERMIT-not to exceed 60 mo.*

Owner / Applicant Signature: TRACY Edwards Date 1/28/09

Improvement Permit by: Maria H. Elson RS Date 1/23/09

Authorization to Construct by: Maria H. Elson RS Date 1/23/09

YOU SHOULD CONTACT A LOCATOR SERVICE PRIOR TO ANY EXCAVATION.

Installed by:

Operation Permit by: Date:

Existing System Inspected by: Maria H. Elson RS Date: 1/23/09

WHITE COPY Environmental Health YELLOW COPY (Final) Owner / Applicant PINK COPY (Initial) Owner / Applicant