IREDELL COUNTY HEALTH DEPARTMENT

↳ AUTHORIZATION TO CONSTRUCT PIN# 4655-60-6172

~~Fee~~ 162

STATESVILLE 704-878-5305 MOORESVILLE 704-664-5281

IMPROVEMENT PERMIT / ~~CERTIFICATE OF COMPLETION~~ / OPERATION PERMIT / EXISTING SYSTEM INSPECTION

PROPERTY DESCRIPTION NO. 25820 DATE 2/6/97 TAX MAP NO. 1C-9-A-21 Watershed: ☐ Yes ☑ No

OWNER OR CONTRACTOR DOUG NELSON PHONE: Business 892-8011 Home 948-4278

ADDRESS 12714 SULGRAVE DR HUNTERSVILLE

LOCATION 1155 - TL FAITH RD - TR MIDWAY LAKE RD - TL BERACAH - 1000' ON LT

SUBDIVISION BERACAH PLACE BLOCK / SECTION ____ LOT 21 LOT AREA 1 AC SITE CLASS. PS DESIGN FLOW 480 GPD L.T.A.R. 1 36 GPD/FT²

Septic Tank: 1000 Gallons; STB 794 Date 3/27/97

Pump Tank: ____ Gallons; PT ____ Date ____

Pump Make: ____ Model ____ Serial No. ____

Nitrification Field: No Fields 1 Square Feet 1620 Linear Feet 540

No Lines 6 @ 90' Trench Width 36" Max Trench Bottom Depth 36" Gravel Depth 12"

☑ New System ☐ Repair System Type: I, (II), III, IV, V, VI

System Description: GRAVITY CONVENTIONAL

Repair System Description: SAME

Maintenance Agreement Required: ☐ Yes ☑ No

☑ House/Mod. Home No. Bedrooms 4

☐ Mobile Home No. Bathrooms 2

☐ Business No. Employees ____

☐ Other ____


☐ Slab ☑ Crawl Space ☐ Basement w/plumbing ☐ Basement wo/plumbing

Water Supply: ☑ Individual ☐ Community ☐ Public

Comments:

Comments:

INITIAL SITE SKETCH 1"=60'

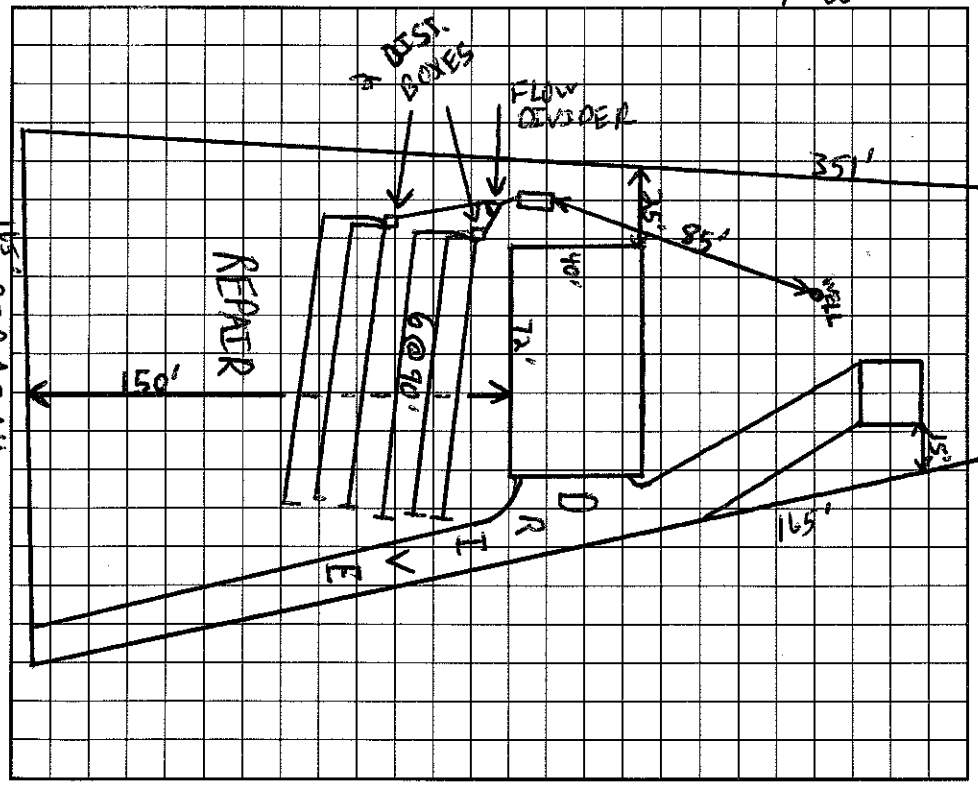

AS BUILT SKETCH

I understand that this permit can be suspended or revoked if any false information is supplied toward securing the permit/any unauthorized changes are made to the site/any unauthorized changes are made in the installation of the system. Improvement Permit is valid for 60 months from date of issuance.

Signed: ____ Installed by: Barry Seymour Const.

Improvement Permit by: EHS date ~~2/6/97~~ 2/6/97 Certificate of Completion by: Wesley Sprouse RS. date 2/3/97

Existing System Inspection by: EHS date 2/6/97 Operation Permit by: Wesley Sprouse RS date 2/3/97

HEALTH DEPT. COPY: WHITE INSPECTION COPY (FINAL): GREEN OWNER COPY (FINAL): YELLOW INSPECTION COPY (INITIAL): PINK OWNER COPY (INITIAL): GOLD