PIN#4655-60-6172

IREDELL COUNTY HEALTH DEPARTMENT

STATESVILLE 704-878-5305 MOORESVILLE 704-664-5281

IMPROVEMENT PERMIT / CERTIFICATE OF COMPLETION / OPERATION PERMIT / EXISTING SYSTEM INSPECTION

PROPERTY DESCRIPTION NO. 19738 DATE 11/30/94 TAX MAP NO. 1C 9A 4 A+of Watershed: ☐ Yes ☑ No

OWNER OR CONTRACTOR D J Bennett PHONE: Business _____ Home 896-8862

ADDRESS 136 Beacah Rd. Mooresville, NC. 28115

LOCATION Midway Lake Rd TR on Beacah Place 3RD lot on (R)

SUBDIVISION Beacah Pl. BLOCK / SECTION _____ LOT 4 LOT AREA ~ 2Ac SITE CLASS. P DESIGN FLOW 36 L.T.A.R. .35

Septic Tank: 1000 Gallons; STB 794 Date 3/6/95

Pump Tank: _____ Gallons; PT _____ Date _____

Pump Make: _____ Model _____ Serial No. _____

Nitrification Field: No Fields 1 Square Feet 1028 Linear Feet 342

No Lines 3 Trench Width 36" Max Trench Bottom Depth 36" Gravel Depth 12"

☑ New System ☐ Repair System Type: I, (II), III, IV, V, VI

System Description: CONV - DIST BOX - SPEED LEVELERS

Repair System Description: _____

Maintenance Agreement Required: ☐ Yes ☑ No

☑ House/Mod. Home No. Bedrooms 3

☐ Mobile Home No. Bathrooms 2.5

☐ Business No. Employees _____

☐ Other _____


☐ Slab ☑ Crawl Space ☐ Basement w/plumbing ☐ Basement wo/plumbing

Water Supply: ☑ Individual ☐ Community ☐ Public

Comments: Keep lines on slope contour

Comments: Installed as drawn.

INITIAL SITE SKETCH

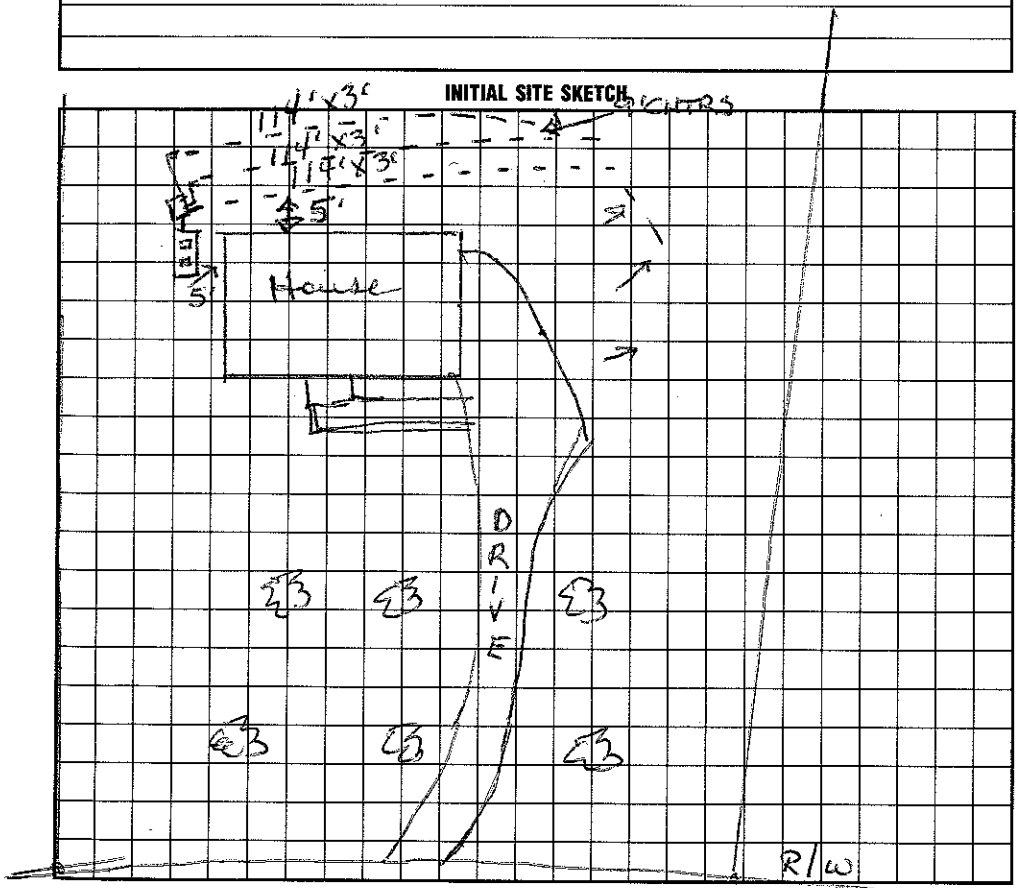

AS BUILT SKETCH

I understand that this permit can be suspended or revoked if any false information is supplied toward securing the permit/any unauthorized changes are made to the site/any unauthorized changes are made in the installation of the system. Improvement Permit is valid for 60 months from date of issuance.

Signed: D J Bennett BEACAH PL.

Improvement Permit by: Wesley Sparkes R.S. date 11/30/94

Existing System Inspection by: _____ date _____

Installed by: F J Ervin

Certificate of Completion by: Wesley Sparkes R.S. date 5/22/95

Operation Permit by: _____ date _____

HEALTH DEPT. COPY: WHITE INSPECTION COPY (FINAL): GREEN OWNER COPY (FINAL): YELLOW INSPECTION COPY (INITIAL): PINK OWNER COPY (INITIAL): GOLD