L COUNTY HEALTH DEPARTMENT

Authorization to Construct PIN# 4655-60-6172

STATESVILLE 704-878-5305 MOORESVILLE 704-664-5281

ROVEMENT PERMIT / ~~CERTIFICATE OF COMPLETION~~ / OPERATION PERMIT / EXISTING SYSTEM INSPECTION

PROPERTY DESCRIPTION NO. 25741 DATE 1/15/97 TAX MAP NO. 1C 9A 21A Watershed: [X] Yes [ ] No

OWNER OR CONTRACTOR Robert Hofpauser PHONE: Business _____ Home _____

ADDRESS 6433 Davidson Hwy Concord, NC. 28027

LOCATION Berach Pl. to 5th house on (L)

SUBDIVISION Berach Pl. BLOCK / SECTION _____ LOT 21A LOT AREA ~ 1Ac SITE CLASS. PS DESIGN FLOW 360 L.T.A.R. .3

Septic Tank: 1000 Gallons; STB 794 Date 12/22/96

Pump Tank: _____ Gallons; PT _____ Date _____

Pump Make: _____ Model _____ Serial No. _____

Nitrification Field: No Fields 1 Square Feet 1200 Linear Feet 400

No Lines 4 Trench Width 36" Max Trench Bottom Depth 36" Gravel Depth 12"

[X] New System [ ] Repair System Type: I, II, III, IV, V, VI

System Description: County - Dist. Box

Repair System Description: Pressure Conv.

Maintenance Agreement Required: [ ] Yes [X] No

[X] House/Mod. Home No. Bedrooms 3

[ ] Mobile Home No. Bathrooms 2

[ ] Business No. Employees _____

[ ] Other _____


[ ] Slab [ ] Crawl Space [ ] Basement w/plumbing [X] Basement wo/plumbing

Water Supply: [X] Individual [ ] Community [ ] Public


Comments:

Comments:

INITIAL SITE SKETCH

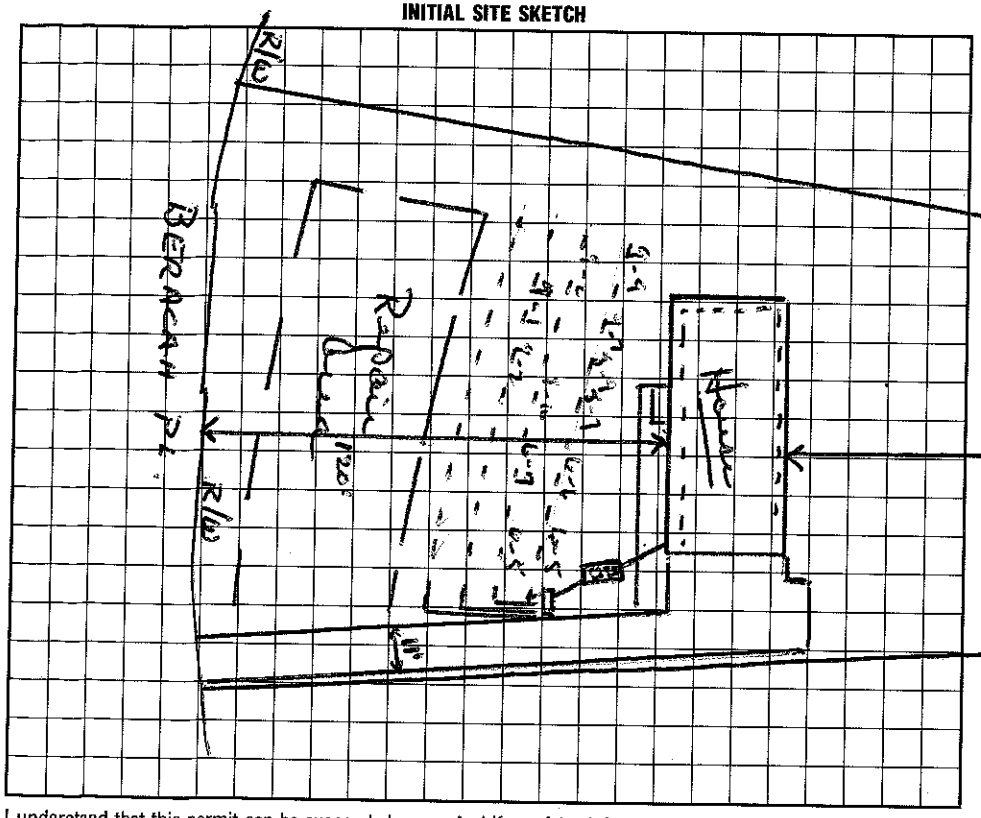

AS BUILT SKETCH

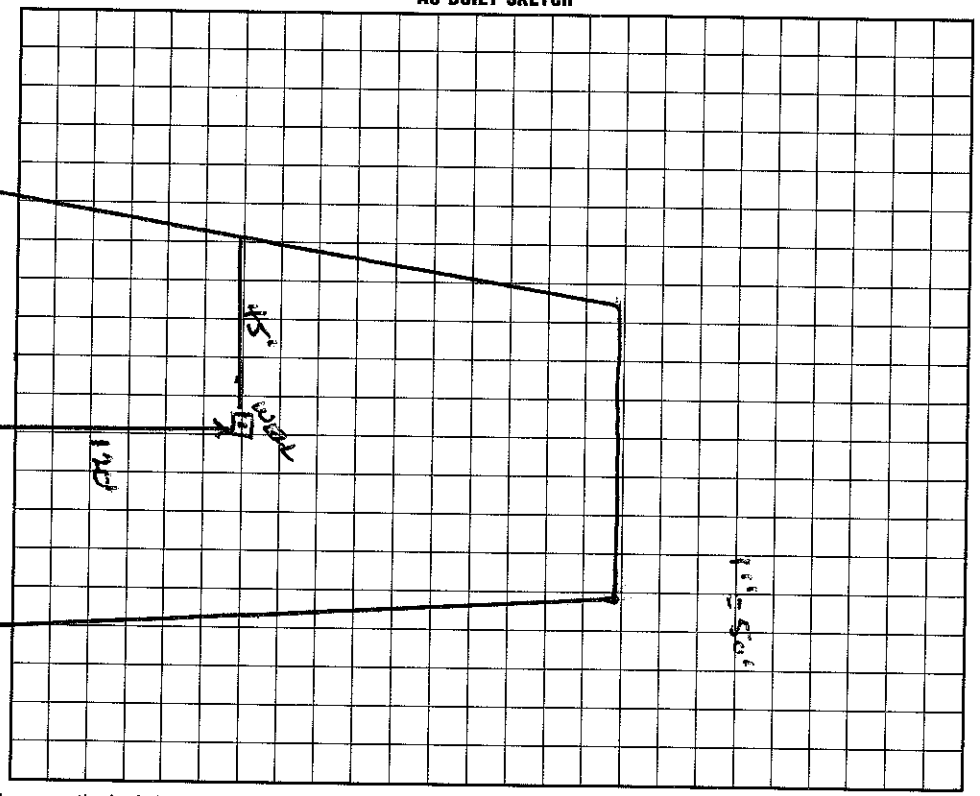

I understand that this permit can be suspended or revoked if any false information is supplied toward securing the permit/any unauthorized changes are made to the site/any unauthorized changes are made in the installation of the system.

Signed: * Robert Hofpauser

Improvement Permit by: Wesley Sparks RS. date 1/15/97

~~Authorization~~ Existing System Inspection by: Wesley Sparks RS. date 1/15/97

Installed by: Ray Hinson Backhoe Service

Certificate of Completion by: Wesley Sparks RS. date 4/10/97

Operation Permit by: Wesley Sparks RS. date 4/10/97

HEALTH DEPT. COPY: WHITE INSPECTION COPY (FINAL): GREEN OWNER COPY (FINAL): YELLOW INSPECTION COPY (INITIAL): PINK OWNER COPY (INITIAL): GOLD