# IREDELL COUNTY HEALTH DEPARTMENT

STATESVILLE 704-878-5305 MOORESVILLE 704-664-5281

PIN# 4655-60-6729

## IMPROVEMENT PERMIT / CERTIFICATE OF COMPLETION / OPERATION PERMIT / EXISTING SYSTEM INSPECTION

PROPERTY DESCRIPTION NO. 16917 DATE 8/30/93

OWNER OR CONTRACTOR STEVE E BROWN TAX MAP NO. 1C 9A 24

ADDRESS 105 BARACH PLACE MOORESVILLE, NC. PHONE: Business _____ Home 545-2992

LOCATION MIDWAY LAKE RD., TR INTO BARACH TO 3RD LOT ON (L)

SUBDIVISION BERACAH PLACE BLOCK / SECTION 1 LOT 24 LOT AREA .96AC SITE CLASS. P L.T.A.R. .25 (3)

Water Supply: ☑ Individual ☐ Community ☐ Public

Septic Tank: 1000 Gallons; STB 358 Date 9/22/93

Pump Tank: _____ Gallons; PT _____ Date _____

Nitrification Field: No Fields 1 Square Feet 1200 ~~1440~~ Linear Feet ~~440~~ 400

No Lines ~~X5~~ Trench Width 36" Trench Depth 28-30" Gravel Depth 12"

☑ New System ☐ Repair System Type: I (II) II, IV, V, VI

System Description: CONV.

Repair System Description: CONV.

Maintenance Agreement Required: ☐ Yes ☑ No

☑ House/Mod. Home No. Bedrooms 3 Garbage Disposal: ☐ Yes ☑ No

☐ Mobile Home No. Bathrooms 2 Auto. Dishwasher: ☑ Yes ☐ No

☐ Business No. Employees _____ Auto. Washing Machine: ☑ Yes ☐ No


☐ Other _____ Other _____

☐ Slab ☑ Crawl Space ☐ Basement w/plumbing ☐ Basement wo/plumbing

Comments Trenches no deeper than 26" to trench bottom. Lines on slope contour in direction shown.

11/4/93 Well not drilled yet

### INITIAL SITE SKETCH

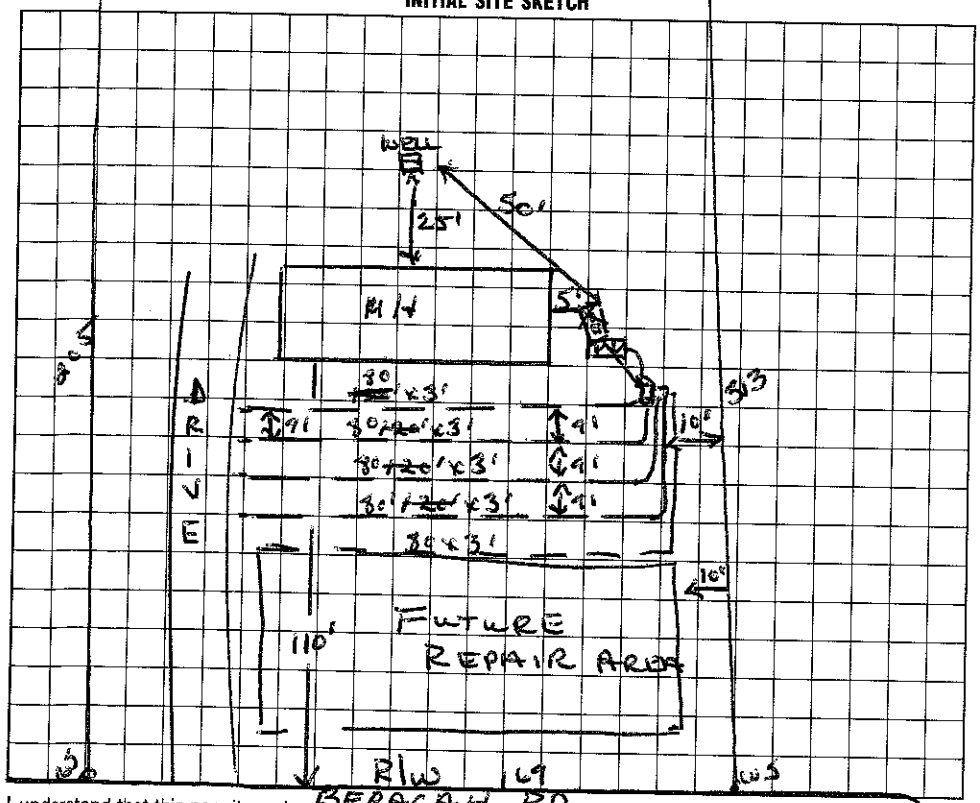


### AS BUILT SKETCH

Installed as shown

I understand that this permit can be suspended or revoked if any false information is supplied toward securing the permit/any unauthorized changes are made to the site/any unauthorized changes are made in the installation of the system. Improvement Permit is valid for 60 months from date of issuance.

Signed: _____

Improvement Permit by: Wesley Sparks RS. date 8/30/93

Existing System Inspection by: _____ date _____

Installed by: LARRY BERRIM

Certificate of Completion by: Wesley Sparks RS. date 11/4/93

Operation Permit by: _____ date _____

HEALTH DEPT. COPY: WHITE INSPECTION COPY (FINAL): GREEN OWNER COPY (FINAL): YELLOW INSPECTION COPY (INITIAL): PINK OWNER COPY (INITIAL): GOLD