IREDELL COUNTY HEALTH DEPARTMENT

PIN# 4655-60-9015

STATESVILLE 704-878-5305 MOORESVILLE 704-664-5281

IMPROVEMENT PERMIT / CERTIFICATE OF COMPLETION / OPERATION PERMIT / EXISTING SYSTEM INSPECTION

PROPERTY DESCRIPTION NO. 17977 DATE 3/15/94 TAX MAP NO. 1C 9 A 10 Watershed: ☑ Yes ☐ No

OWNER OR CONTRACTOR ML Young Const. Co. PHONE: Business 664-2774 Home

ADDRESS Rt 10 Box 664 Mooresville, NC. 28115

LOCATION Midway Lake Rd. off 115 S TR Beracah Rd., 5th. lot on (R)

SUBDIVISION Beracah Place BLOCK / SECTION LOT 5 LOT AREA SITE CLASS. P DESIGN FLOW 360 L.T.A.R. .25

Septic Tank: 1600 ✓ Gallons; STB 794 Date 6-15-94

Pump Tank: Gallons; PT Date

Pump Make: Model Serial No.

Nitrification Field: No Fields 1 Square Feet 1200 Linear Feet 400

No Lines 4 Trench Width 3' Max Trench Bottom Depth 36" Gravel Depth 12"

☑ New System ☐ Repair System Type: I (II) III, IV, V, VI

System Description: CONV - DIST. BOX

Repair System Description:

Maintenance Agreement Required: ☐ Yes ☐ No

☑ House/Mod. Home No. Bedrooms 3

☐ Mobile Home No. Bathrooms 2

☐ Business No. Employees

☐ Other


☐ Slab ☑ Crawl Space ☐ Basement w/plumbing ☐ Basement wo/plumbing

Water Supply: ☑ Individual ☐ Community ☐ Public REG#1451

Comments: Repair Area

Comments: TEE - KNOCKOUT - SEAL → O.K. BOX OUTLETS O/K. OUTLETS SET TO FEED EQUALLY. CENTERS MAINTAINED → OK.

INITIAL SITE SKETCH

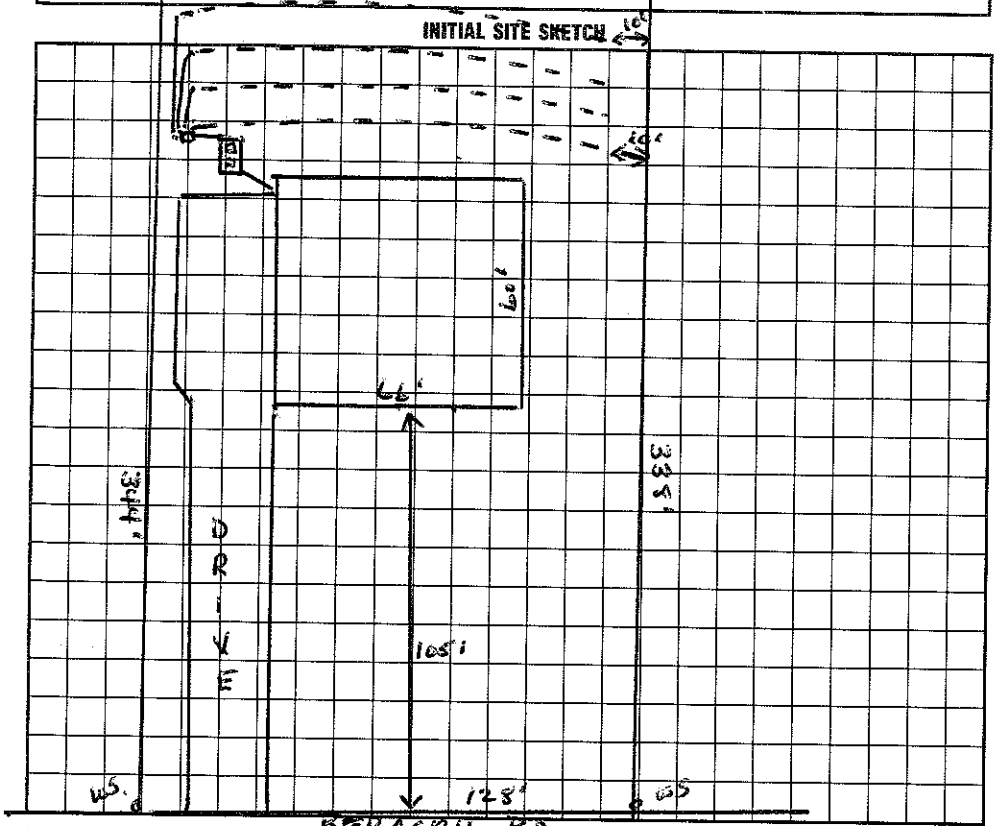


AS BUILT SKETCH

COMPLETED 5-31-94

DEPTH 270'

CAS. DEPTH 80'

8 gpm

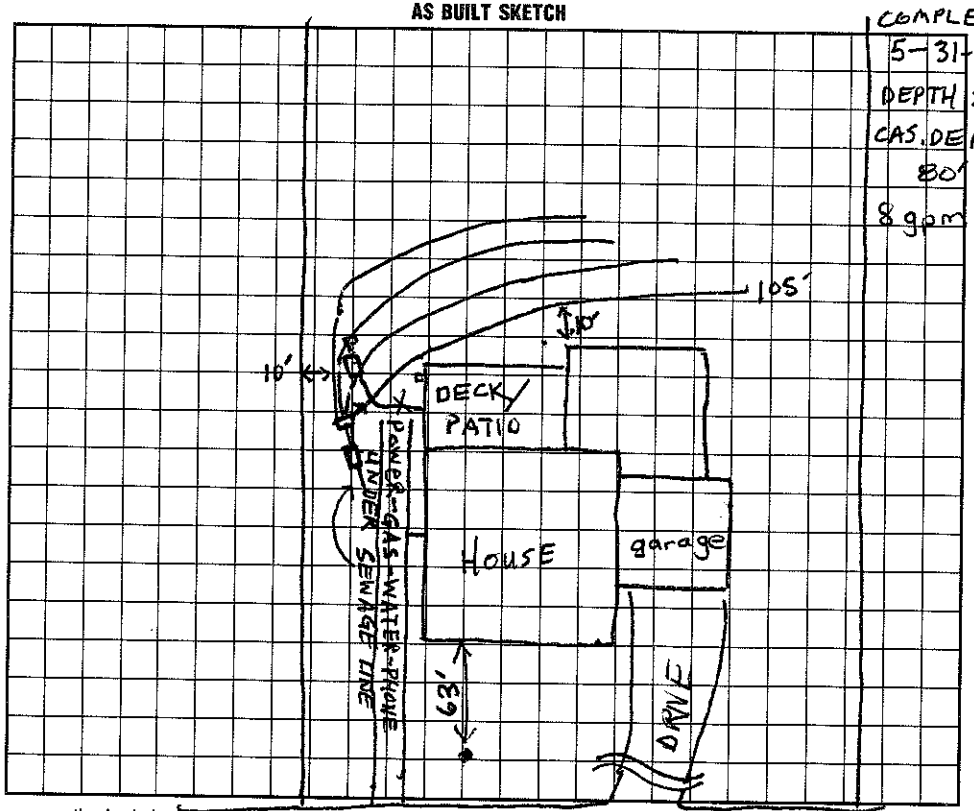

I understand that this permit can be suspended or revoked if any false information is supplied toward securing the permit/any unauthorized changes are made to the site/any unauthorized changes are made in the installation of the system. Improvement Permit is valid for 60 months from date of issuance.

Signed:

Improvement Permit by: Wesley Sparks RS. date 3/15/94

Existing System Inspection by: date

Installed by: F. J. ERVIN

Certificate of Completion by: Andrea Lemon date 8-9-94

Operation Permit by: date

HEALTH DEPT. COPY: WHITE INSPECTION COPY (FINAL): GREEN OWNER COPY (FINAL): YELLOW INSPECTION COPY (INITIAL): PINK OWNER COPY (INITIAL): GOLD