IREDELL COUNTY HEALTH DEPARTMENT

STATESVILLE 704-878-5305 130.

IMPROVEMENT PERMIT / AUTHORIZATION TO CONSTRUCT / OPERATION PERMIT / Existing

PERMIT# 12169 PIN# 4655612090 Marty DATE 6-17-04

OWNER OR CONTRACTOR Ward Diversified PHONE: Business 828 478-44 Home 902-3907

ADDRESS 8156 Monbo Rd Catawba, NC 28609

LOCATION Hwy 115 S TL Midway Lake to corner lot at Midway Lake & Beracah Rd - 106 Beracah Rd

SUBDIVISION Beracah BLOCK / SECTION J LOT 1 LOT AREA .78 Acre SITE CLASS PS DESIGN FLOW 360gpd L.T.A.R. .3

Septic Tank: 1000 Gallons; STB 1012 Date 5-18-04

Pump Tank: ~~1000~~ Gallons; PT _____ Date _____

Pump Make: _____ Model _____ Serial No. _____

Nitrification Field: No Fields 1 Square Feet 600' Linear Feet 200'

No Lines 5@40' Trench Width 24"-36" Max Trench Bottom Depth 30" Gravel Depth N/A

☒ New System ☐ Repair System Type: I, II, III, IV, V, VI

System Description: ~~Pump-1 P-Panel Block~~

Repair System Description: Pump-1 P-Panel Block

Maintenance Agreement Required: ☐ Yes ☒ No

☒ House/Mod. Home No. Bedrooms 3

☐ Mobile Home No. Bathrooms ____

☐ Business No. Employees ____

☐ Other _____


☐ Slab ☐ Crawl Space ☒ Basement w/plumbing ☐ Basement wo/plumbing

Water Supply: ☐ Individual ☐ Public ☐ Community


Comments:/Conditions: Keep Drainfield 25' from basement wall.

Comments:/Conditions: ~~X~~ Note: May not have to be pumped if plumbing stubbed out high enough & gravity pump used for basement plumbing.

INITIAL SITE SKETCH Scale 1:50

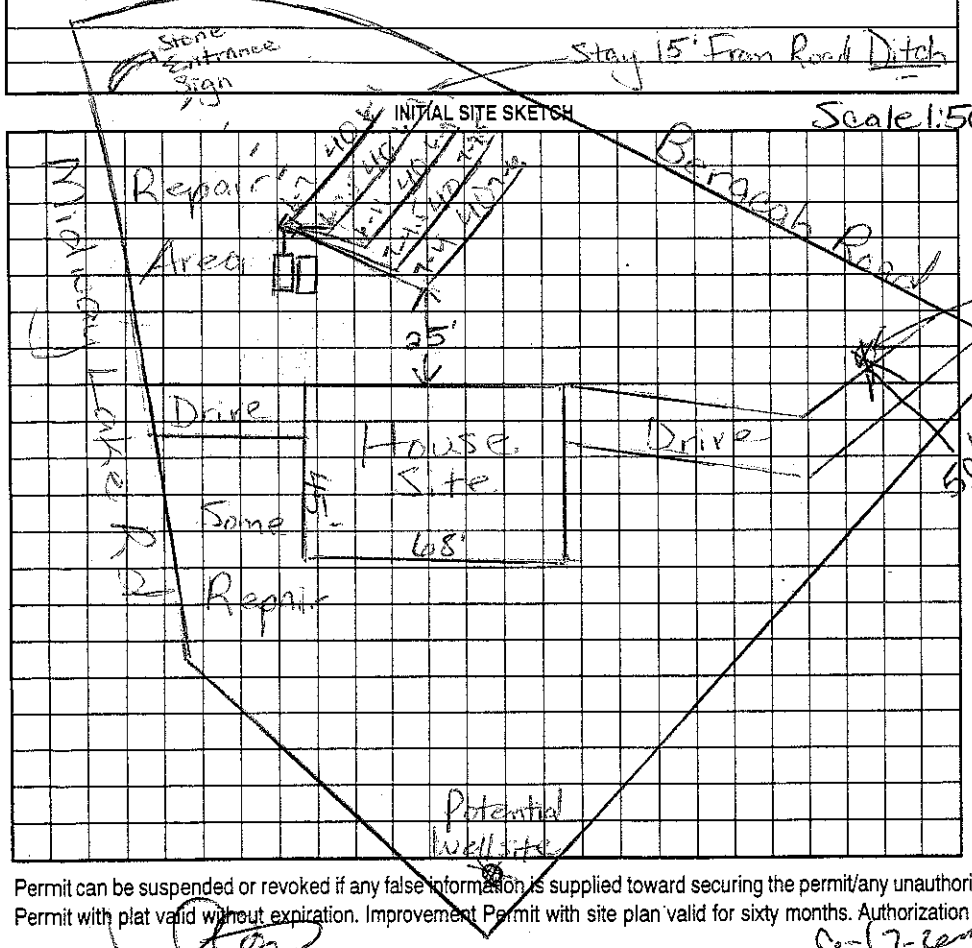

AS BUILT SKETCH

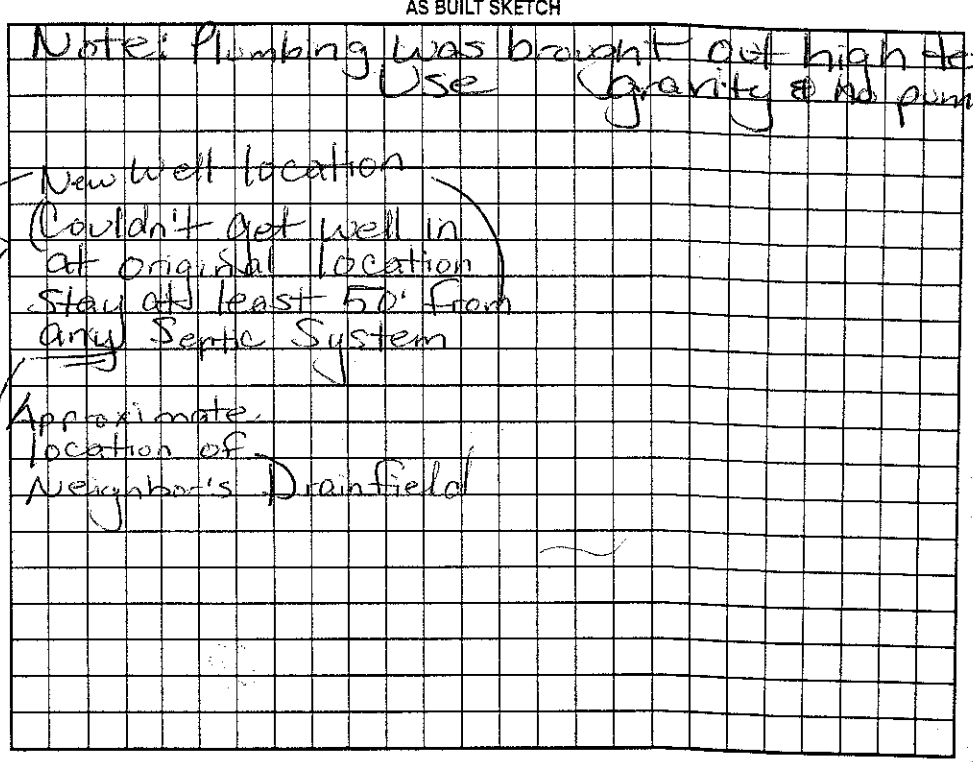

Permit can be suspended or revoked if any false information is supplied toward securing the permit/any unauthorized changes are made to the site/any unauthorized changes are made in the installation of the system. Improvement Permit with plat valid without expiration. Improvement Permit with site plan valid for sixty months. Authorization to Construct is valid for a period equal to that of Improvement Permit – not to exceed sixty months.

Signed: _____ date 6-17-2004 Installed by: Tommy Fryar 704-902-1380

Improvement Permit by: Marvin H. Dotson RS date 6/17/04 Operation Permit by: Marty Sparks R.S. date 11/15/04

Authorization to Construct by: Marvin H. Dotson RS date 6/17/04 Existing System Inspection by: _____ date _____

HEALTH DEPT. COPY: WHITE OWNER COPY (FINAL): YELLOW OWNER COPY (INITIAL): PINK