IREDELL COUNTY HEALTH DEPARTMENT

Authorization to Construct

~~STATESVILLE~~ 704-878-5305 MOORESVILLE 704-664-5281

IMPROVEMENT PERMIT / ~~CERTIFICATE OF COMPLETION~~ / OPERATION PERMIT / EXISTING SYSTEM INSPECTION

PROPERTY DESCRIPTION NO. 23797 DATE 6/3/96 TAX MAP NO. 1C 9 A 26 Watershed: ☐ Yes ☒ No

OWNER OR CONTRACTOR Kenneth D Stewart PHONE: Business 483-9568 Home

ADDRESS 4443 Brentfield Court Marden, NC. 28650

LOCATION 115 S TL Midway Lake Rd TR on Beracah Pl. first lot on (L) corner

SUBDIVISION Beracah Pl. BLOCK / SECTION LOT 26 LOT AREA ~.9AC SITE CLASS. PS DESIGN FLOW 360 L.T.A.R. .3

Septic Tank: 1000 Gallons; STB Date

Pump Tank: Gallons; PT Date

Pump Make: Model Serial No.

Nitrification Field: No Fields 1 Square Feet 1200 Linear Feet 400

No Lines 3 Trench Width 36" Max Trench Bottom Depth 36" Gravel Depth

☒ New System ☐ Repair System Type: I. II. III. IV. V. VI

System Description: CONV - GRAVITY

Repair System Description:

Maintenance Agreement Required: ☐ Yes ☒ No

☒ House/Mod. Home No. Bedrooms 3

☐ Mobile Home No. Bathrooms 2

☐ Business No. Employees

☐ Other


☐ Slab ☒ Crawl Space ☐ Basement w/plumbing ☐ Basement wo/plumbing

Water Supply: ☒ Individual ☐ Community ☐ Public


Comments:

Comments:

INITIAL SITE SKETCH

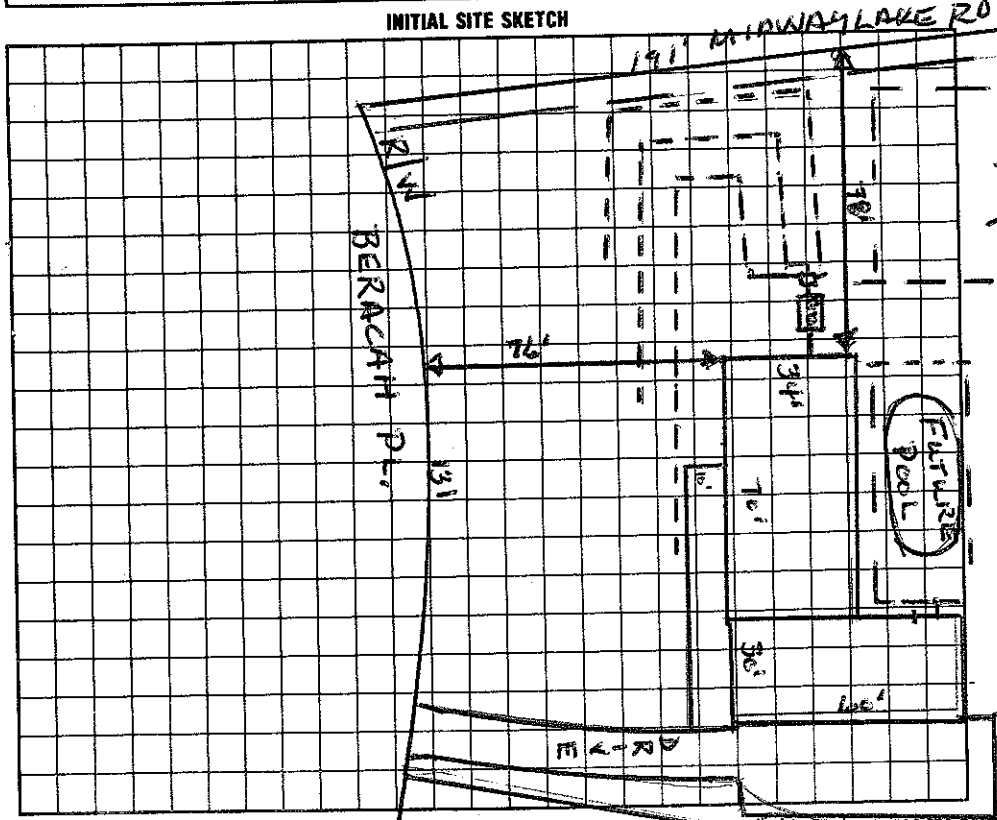

AS BUILT SKETCH

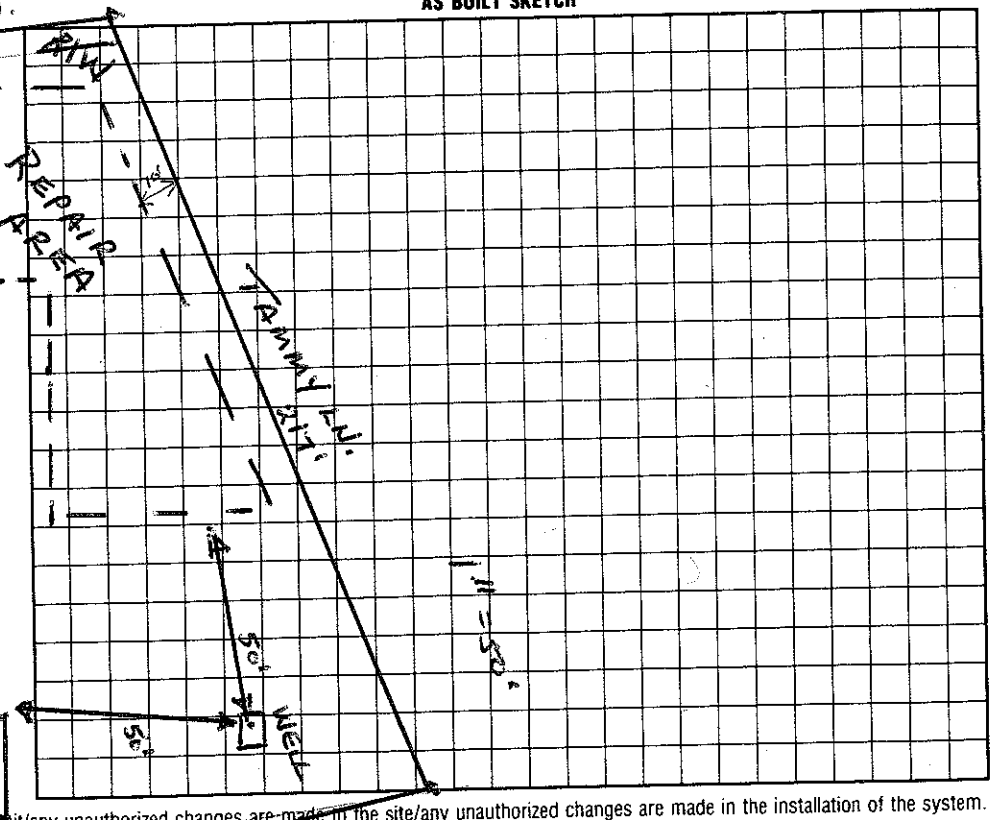

I understand that this permit can be suspended or revoked if any false information is supplied toward securing the permit/any unauthorized changes are made to the site/any unauthorized changes are made in the installation of the system.

Authorization to Construct valid 5 years. 196

Signed: Kenneth D. Stewart

Improvement Permit by: Wesley Sparks RS. date 6/3/96

Authorization to Construct: Wesley Sparks RS. date 6/3/96

Existing System Inspection by:

Installed by:

Certificate of Completion by: date

Operation Permit by: date

HEALTH DEPT. COPY: WHITE INSPECTION COPY (FINAL): GREEN OWNER COPY (FINAL): YELLOW INSPECTION COPY (INITIAL): PINK OWNER COPY (INITIAL): GOLD