IREDELL COUNTY HEALTH DEPARTMENT

STATESVILLE 704-878-5305 MOORESVILLE 704-664-5281

IMPROVEMENT PERMIT / AUTHORIZATION TO CONSTRUCT / OPERATION PERMIT / EXISTING SYSTEM INSPECTION

PERMIT# 076489 PIN# 4655 61 4260 DATE 9/15/98

OWNER OR CONTRACTOR Ronald R. Burford PHONE: Business 895-4059 Home

ADDRESS PO Box 217 Mt Mourne NC 28123

LOCATION 1155 TL Midway Lake TR Beracah Place, corner lot on (L)

SUBDIVISION Beracah Place BLOCK / SECTION LOT 26 LOT AREA .96 Ac SITE CLASS PS DESIGN FLOW 360 L.T.A.R. .3

Septic Tank: 1000 Gallons; STB 194 Date 1/9/98
Pump Tank: Gallons; PT Date
Pump Make: Model Serial No.
Nitrification Field: No Fields 1 Square Feet 1200 Linear Feet 400
No Lines 4 Trench Width 36" Max Trench Bottom Depth 36" Gravel Depth 12"

[X] New System ☐ Repair System Type: I, II, III, IV, V, VI
System Description: GRAV - CONVENTIONAL
Repair System Description: PRESSURE CONVENTIONAL
Maintenance Agreement Required: ☐ Yes [X] No


[X] House/Mod. Home No. Bedrooms 3
☐ Mobile Home No. Bathrooms 3
☐ Business No. Employees
☐ Other

☐ Slab [X] Crawl Space ☐ Basement w/plumbing ☐ Basement wo/plumbing

Water Supply: [X] Individual ☐ Public ☐ Community

Comments:/Conditions:

INITIAL SITE SKETCH (1" = 60')

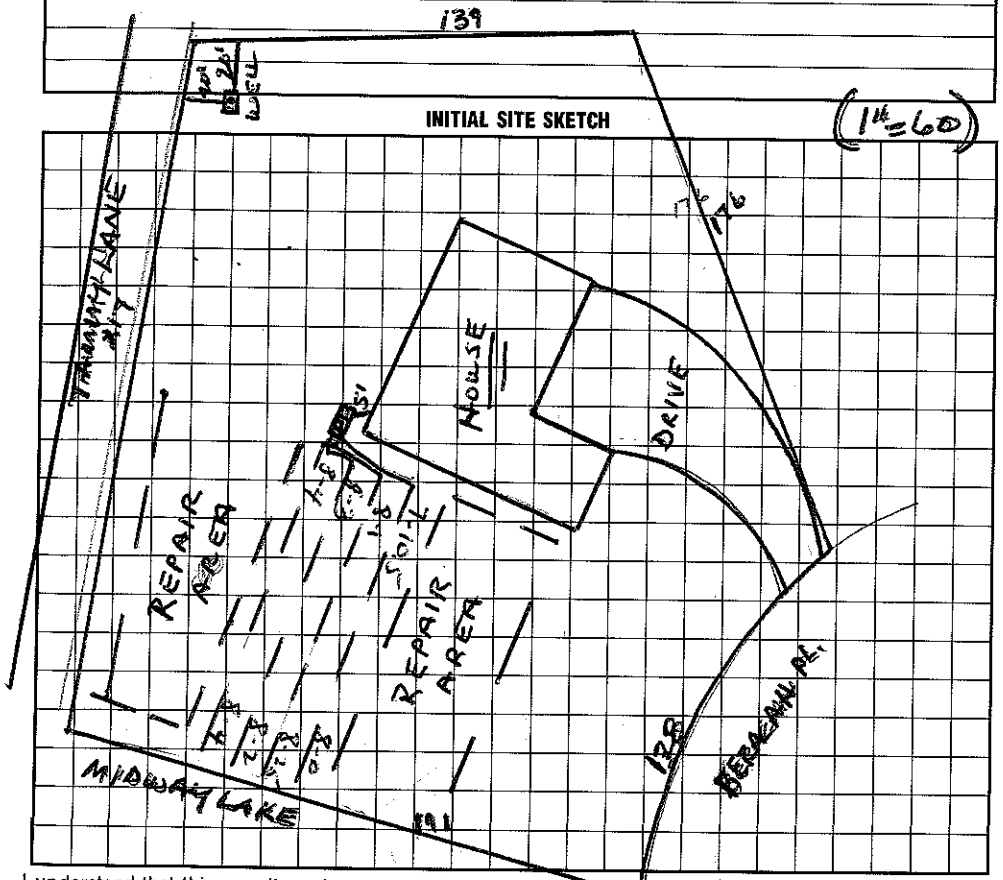

Comments:/Conditions:

AS BUILT SKETCH

I understand that this permit can be suspended or revoked if any false information is supplied toward securing the permit/any unauthorized changes are made to the site/any unauthorized changes are made in the installation of the system. Improvement Permit with plat valid without expiration. Improvement Permit with site plan valid for sixty months. Authorization to Construct is valid for a period equal to that of Improvement Permit – not to exceed sixty months.

Signed: Jon Burford date 9/17/98

Improvement Permit by: Wesley Sparks RS. date 9/15/98

Authorization to Construct by: Wesley Sparks RS. date 9/15/98

Installed by: F J Ervin

Operation Permit by: Wesley Sparks RS date 3/11/99

Existing System Inspection by: date

HEALTH DEPT. COPY: WHITE INSPECTION COPY (FINAL): GREEN OWNER COPY (FINAL): YELLOW INSPECTION COPY (INITIAL): PINK OWNER COPY (INITIAL): GOLD