IREDELL COUNTY HEALTH DEPARTMENT

STATESVILLE 704-878-5305 MOORESVILLE 704-664-5281

IMPROVEMENT PERMIT / AUTHORIZATION TO CONSTRUCT / OPERATION PERMIT / EXISTING SYSTEM INSPECTION

PERMIT# 077341 PIN# 4655 62 1482 DATE 12/14/98

OWNER OR CONTRACTOR Thomas M Knox PHONE: Business 549-1246 Home

ADDRESS PO Box 561481 Charlotte, NC. 28256

LOCATION Midway Lake Rd. 1153 TL Midway Lake Rd. just past #296 Midway Lake Rd.

SUBDIVISION No BLOCK / SECTION LOT LOT AREA .96 Ac. SITE CLASS PS DESIGN FLOW 360 L.T.A.R. .3

Septic Tank: 1000 Gallons; STB 312 Date 8/12/00
Pump Tank: Gallons; PT Date
Pump Make: Model Serial No.
Nitrification Field: No Fields 1 Square Feet 1200 Linear Feet 400
No Lines 4 Trench Width 36" Max Trench Bottom Depth 36" Gravel Depth 12"

X New System ☐ Repair System Type: I (II) III, IV, V, VI
System Description: ~~Standard Conventional~~ 16" PPBS EZ Flow
Repair System Description:
Maintenance Agreement Required: ☐ Yes ☐ No

X House/Mod. Home No. Bedrooms 3
☐ Mobile Home No. Bathrooms 2
☐ Business No. Employees
☐ Other


☐ Slab ☐ Crawl Space ☐ Basement w/plumbing ☐ Basement wo/plumbing

Water Supply: X Individual ☐ Public ☐ Community

Comments:/Conditions:

Comments:/Conditions:
300' of Ez Flow installed.

INITIAL SITE SKETCH

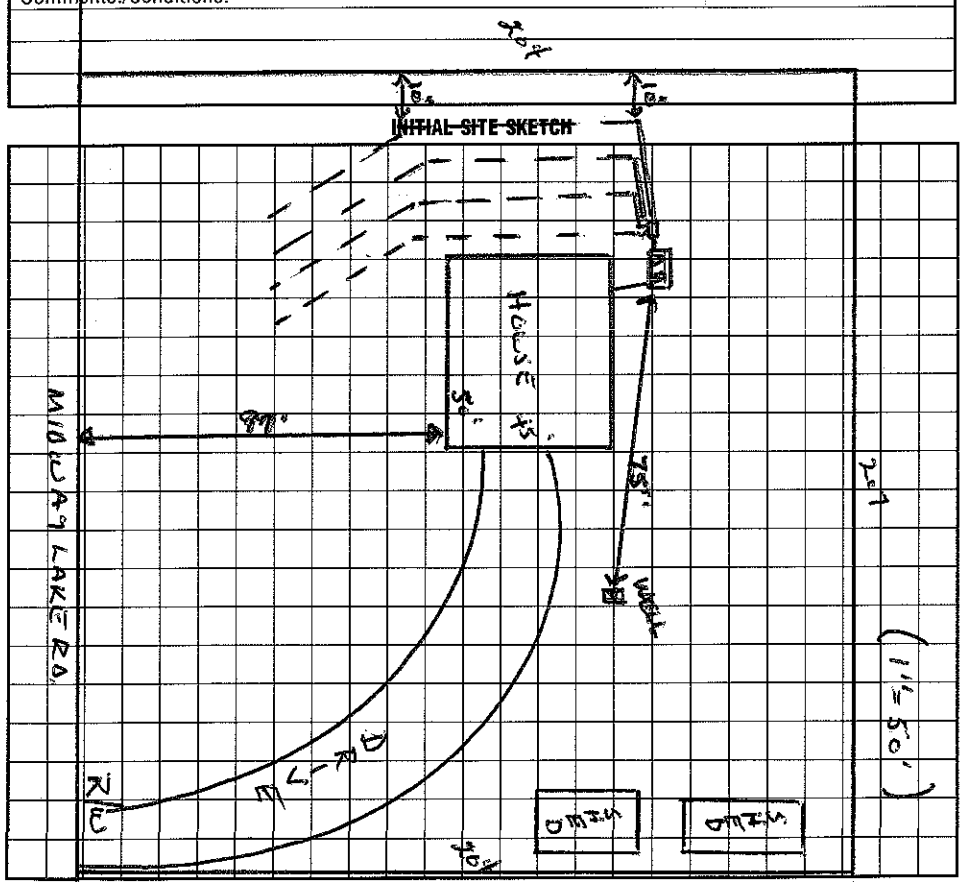

AS BUILT SKETCH

I understand that this permit can be suspended or revoked if any false information is supplied toward securing the permit/any unauthorized changes are made to the site/any unauthorized changes are made in the installation of the system. Improvement Permit with plat valid without expiration. Improvement Permit with site plan valid for sixty months. Authorization to Construct is valid for a period equal to that of Improvement Permit – not to exceed sixty months.

Signed: * Mabel P. Knox date 12-15-98 Installed by: Bob Mayhew

Improvement Permit by: date Operation Permit by: Wesley Sparks R.S. date 9/21/00

Authorization to Construct by: Wesley Sparks R.S. date 12/14/98 Existing System Inspection by: date

HEALTH DEPT. COPY: WHITE INSPECTION COPY (FINAL): GREEN OWNER COPY (FINAL): YELLOW INSPECTION COPY (INITIAL): PINK OWNER COPY (INITIAL): GOLD