1.30

IREDELL COUNTY HEALTH DEPARTMENT

STATESVILLE 704-878-5305 MOORESVILLE 704-664-5281

IMPROVEMENT PERMIT / AUTHORIZATION TO CONSTRUCT / OPERATION PERMIT / EXISTING SYSTEM INSPECTION

PERMIT# 078886 PIN# ~~4655-53-3032~~ 4655 62 1655 DATE 1/29/99

OWNER OR CONTRACTOR Ryan B. Knopf PHONE: Business _____ Home 892-0600

ADDRESS 258 Midway Lake Rd Mooresville, NC. 28115

LOCATION 1155 To Midway Lake Rd, 1.25 mile on (L)

SUBDIVISION _____ BLOCK / SECTION _____ LOT N/A LOT AREA 1.14 Ac. SITE CLASS. PS DESIGN FLOW 360 L.T.A.R. .3

Septic Tank: 1000 Gallons; STB 1012 Date 3/4/99
Pump Tank: _____ Gallons; PT _____ Date _____
Pump Make: _____ Model _____ Serial No. _____
Nitrification Field: No Fields 1 Square Feet 900 ✓ Linear Feet 300 ✓
No Lines 3 Trench Width 36" Max Trench Bottom Depth 36" Gravel Depth SAND

☒ New System ☐ Repair System Type: I, II, III, IV, V, VI
System Description: Drainfield - Cultec
Repair System Description: Same
Maintenance Agreement Required: ☐ Yes ☒ No

☒ House/Mod. Home No. Bedrooms 3
☐ Mobile Home No. Bathrooms 3
☐ Business No. Employees ____
☐ Other _____
☐ Slab ☒ Crawl Space ☐ Basement w/plumbing ☐ Basement wo/plumbing


Water Supply: ☒ Individual ☐ Public ☐ Community

Comments:/Conditions:

Comments:/Conditions:

(1"=50')

INITIAL SITE SKETCH

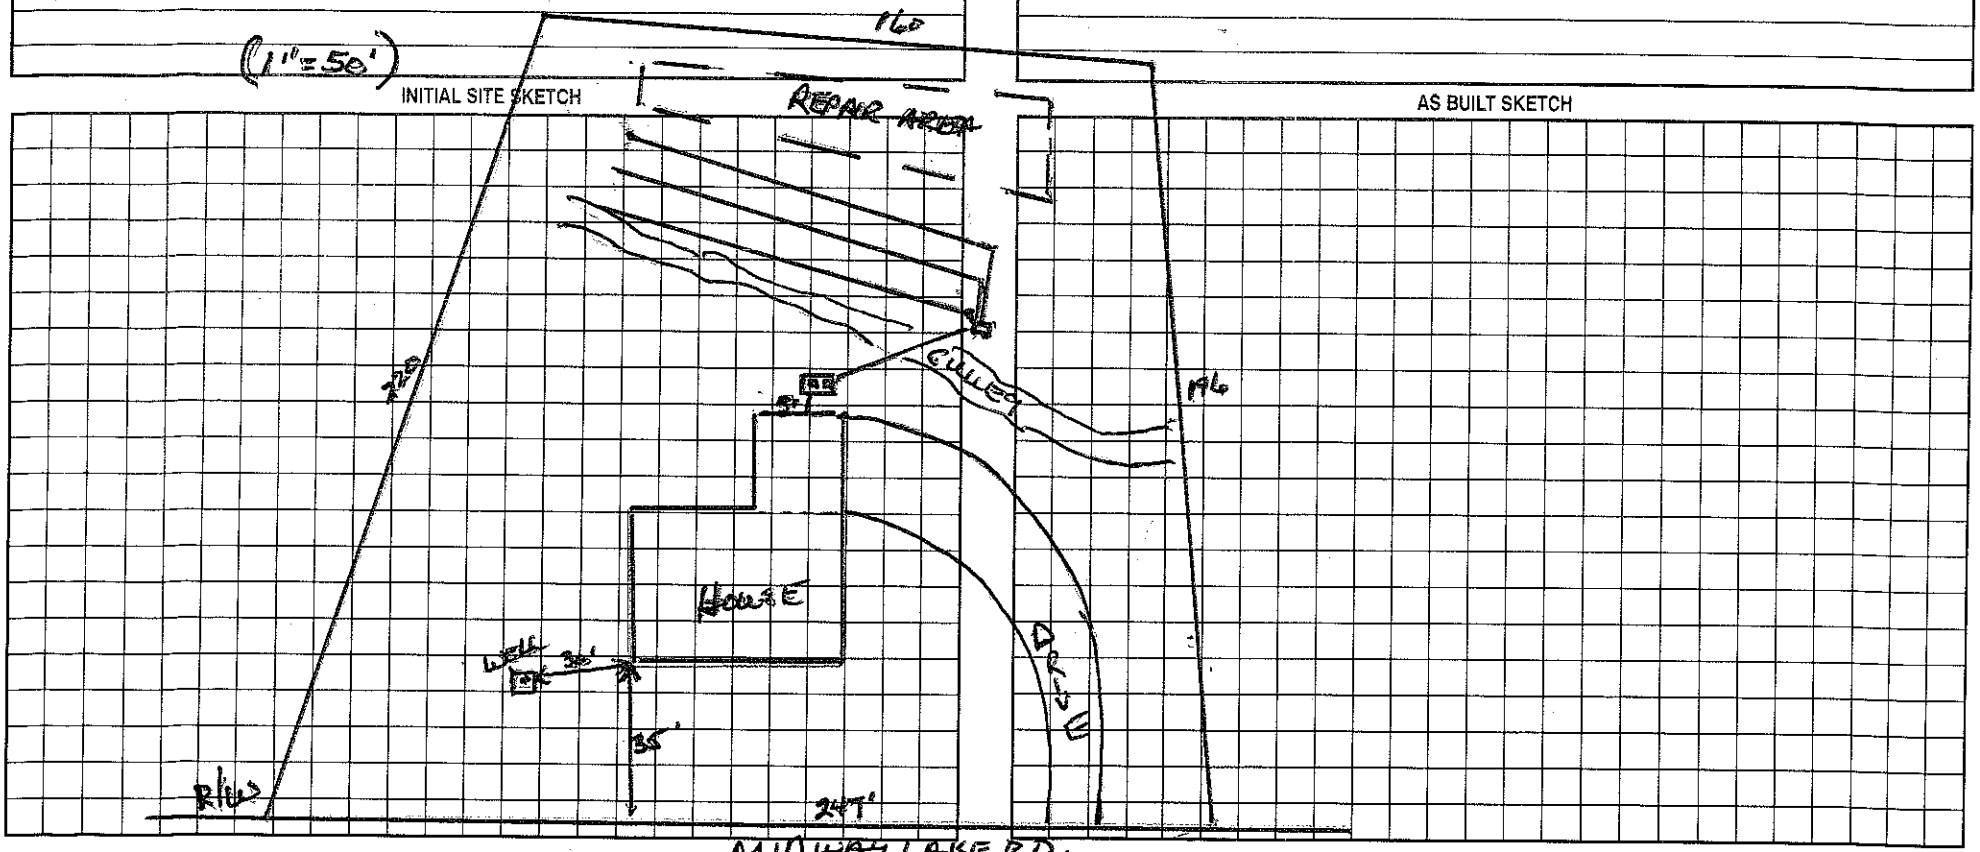

AS BUILT SKETCH

Permit can be suspended or revoked if any false information is supplied toward securing the permit/any unauthorized changes are made to the site/any unauthorized changes are made in the installation of the system. Improvement Permit with plat valid without expiration. Improvement Permit with site plan valid for sixty months. Authorization to Construct is valid for a period equal to that of Improvement Permit – not to exceed sixty months.

Signed: ✓ Tom Danner date 2-8-99

Improvement Permit by: Wesley Sparks R.S. date 2/8/99

Authorization to Construct by: Wesley Sparks R.S. date 2/8/99

Installed by: E. Elder

Operation Permit by: C. [signature] R.S. date 5/12/99

Existing System Inspection by: _____ date _____

HEALTH DEPT. COPY: WHITE OWNER COPY (FINAL): YELLOW OWNER COPY (INITIAL): PINK