IREDELL COUNTY HEALTH DEPARTMENT

STATESVILLE 704-878-5305 150.00 Paid MOORESVILLE 704-664-5281 11:00

IMPROVEMENT PERMIT / AUTHORIZATION TO CONSTRUCT / OPERATION PERMIT / EXISTING SYSTEM INSPECTION

PERMIT# 104 930 PIN# 4655 62 6728 DATE 3/6/02

OWNER OR CONTRACTOR Chantopher Goodnum PHONE: Business Home 704-663-1563

ADDRESS 277 Midway Lake Rd. Mooresville, NC. 28117

LOCATION 1155 TL Faith Rd. TR Midway Lake Rd. ~.7 mi on (L) 277 Midway Lake Rd.

SUBDIVISION No BLOCK / SECTION LOT LOT AREA ~10.04Ac SITE CLASS. PS DESIGN FLOW 480 L.T.A.R. .3

Septic Tank: EXISTING Gallons; STB Date
Pump Tank: Gallons; PT Date
Pump Make: Model Serial No.
Nitrification Field: No Fields 1 Square Feet 600 Linear Feet 200
No Lines 2@100' Trench Width 3' Max Trench Bottom Depth 3' Gravel Depth 12"

☐ New System ☐ Repair System Type: I, (II), III, IV, V, VI
System Description: Add to System
Repair System Description:
Maintenance Agreement Required: ☐ Yes ☐ No


☑ House/Mod. Home No. Bedrooms 4
☐ Mobile Home No. Bathrooms 2.5
☐ Business No. Employees
☐ Other
☐ Slab ☒ Crawl Space ☐ Basement w/plumbing ☐ Basement wo/plumbing

Water Supply: ☐ Individual ☐ Public ☐ Community

Comments:/Conditions: Adding to system to handle extra proposed Bedroom.

Comments:/Conditions:

INITIAL SITE SKETCH

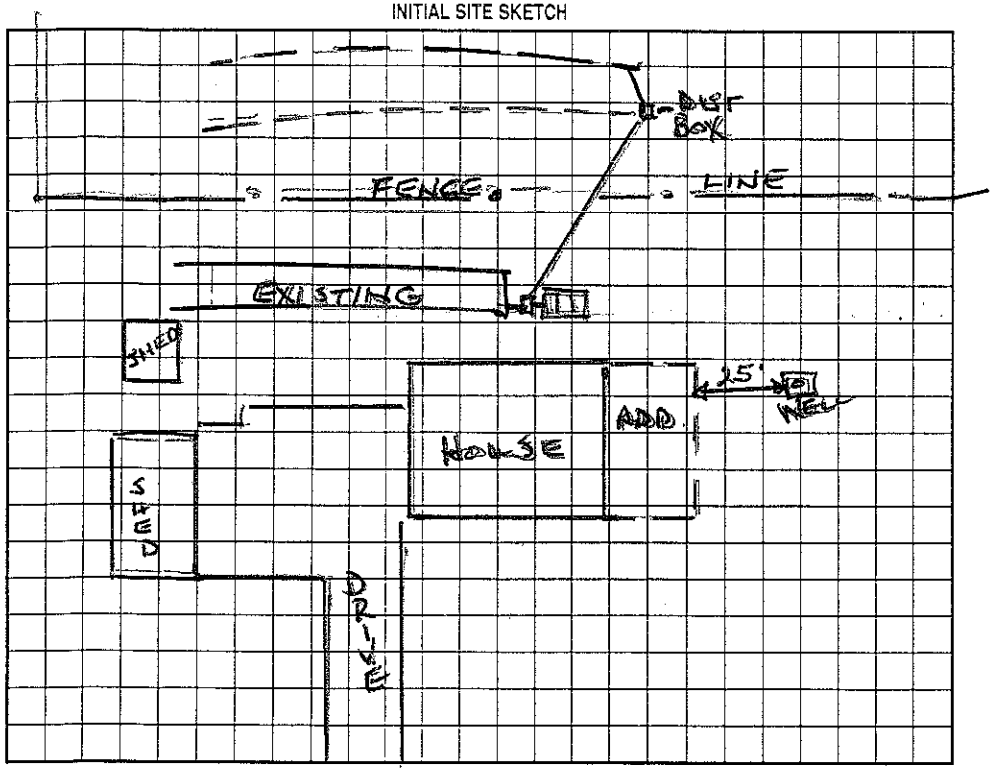

AS BUILT SKETCH

Installed as Drawn
Conventional drainfield

Permit can be suspended or revoked if any false information is supplied toward securing the permit/any unauthorized changes are made to the site/any unauthorized changes are made in the installation of the system. Improvement Permit with plat valid without expiration. Improvement Permit with site plan valid for sixty months. Authorization to Construct is valid for a period equal to that of Improvement Permit – not to exceed sixty months.

Signed: x Dustin Miller for Goodnum date 3/8/02
Improvement Permit by: Wesley Sparks RS date 3/6/02
Authorization to Construct by: Wesley Sparks RS date 3/6/02

Installed by: Richard Abernathy
Operation Permit by: Marian H. Dotson RS date 4/25/2002
Existing System Inspection by: Marian H. Dotson RS date 4/25/2002

HEALTH DEPT. COPY: WHITE OWNER COPY (FINAL): YELLOW OWNER COPY (INITIAL): PINK