4655 63 2194

IREDELL COUNTY HEALTH DEPARTMENT

STATESVILLE 704-878-5305 MOORESVILLE 704-664-5281

IMPROVEMENT PERMIT / AUTHORIZATION TO CONSTRUCT / OPERATION PERMIT / EXISTING SYSTEM INSPECTION

PERMIT# 074334 PIN# 4655625869 PT wk 552-2272 DATE 7/20/98

OWNER OR CONTRACTOR Ethel & Roger Sellers PHONE: Business 892-7412 Home Hopkins 875-0680 M 309-7328

ADDRESS 16424 Green Dolphin Ln Cornelius NC 28031

LOCATION 115 S TL Midway Lake on left before Grady's Farm Rd (Sits far back off Road)

SUBDIVISION ____ BLOCK / SECTION ____ LOT ____ LOT AREA 5.95 Acre SITE CLASS. B DESIGN FLOW 460gpd L.T.A.R. .3

Septic Tank: 1000 Gallons; STB 794 Date 12/20/98
Pump Tank: ____ Gallons; PT ____ Date ____
Pump Make: ____ Model ____ Serial No. ____
Nitrification Field: No Fields 1 Square Feet 1596' Linear Feet 532'
No Lines 4 at 133' Trench Width 36" Max Trench Bottom Depth 28" Gravel Depth 12"

☒ New System ☐ Repair System Type: I, II, III, IV, V, VI
System Description: Gravity - Conventional
Repair System Description: Same
Maintenance Agreement Required: ☐ Yes ☒ No

☒ House/Mod. Home No. Bedrooms 4
☐ Mobile Home No. Bathrooms 2.5
☐ Business No. Employees ____
☐ Other ____
☐ Slab ☒ Crawl Space ☐ Basement w/plumbing ☐ Basement wo/plumbing


Water Supply: ☒ Individual ☐ Public ☐ Community

Comments:/Conditions: Keep Septic System at least 5' from House, 10' from PL & 100' from well.


Comments:/Conditions:

Scale 1:100

INITIAL SITE SKETCH

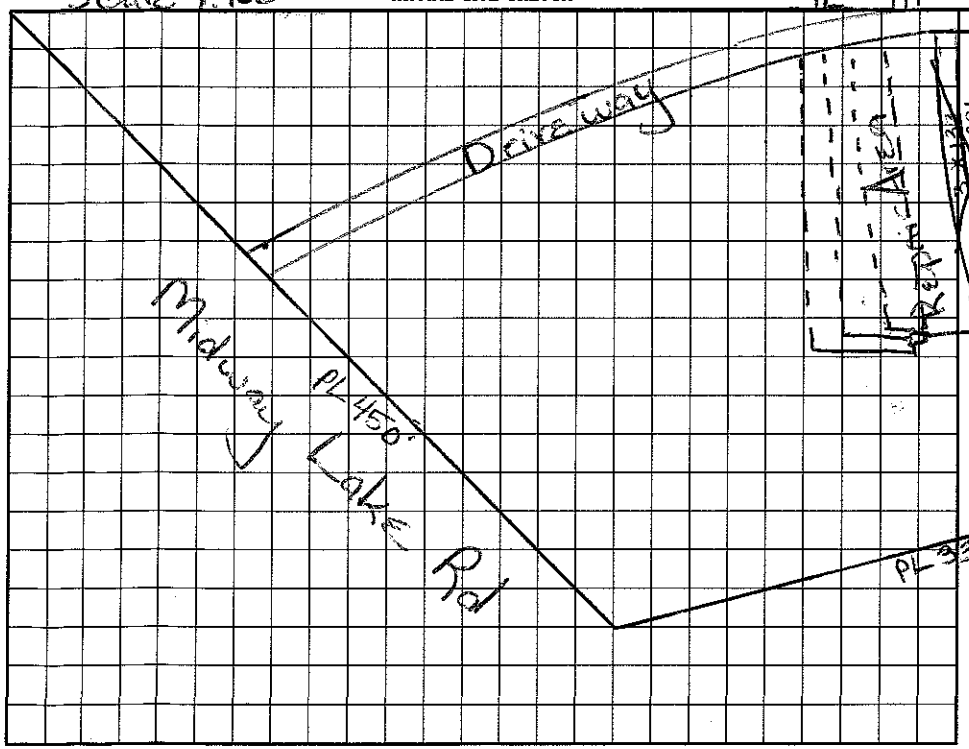

AS BUILT SKETCH

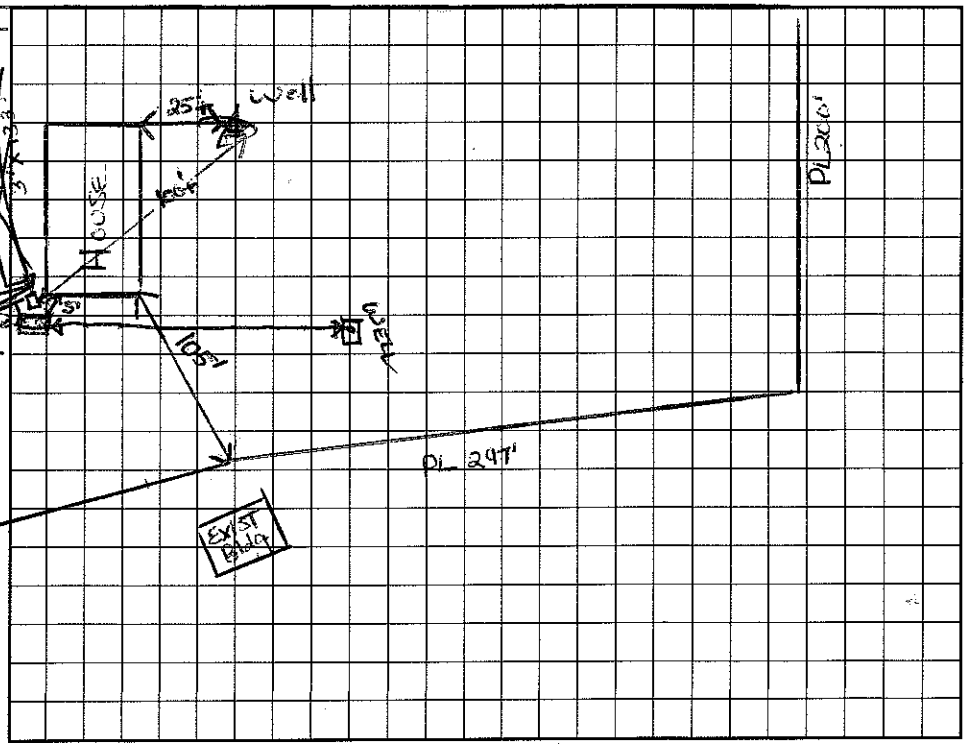

I understand that this permit can be suspended or revoked if any false information is supplied toward securing the permit/any unauthorized changes are made to the site/any unauthorized changes are made in the installation of the system. Improvement Permit with plat valid without expiration. Improvement Permit with site plan valid for sixty months. Authorization to Construct is valid for a period equal to that of Improvement Permit – not to exceed sixty months.

Signed: L. H. Walker Jr. date 10/21/98 Installed by: Bob Mayhew

Improvement Permit by: Maria H. Dotson date 7/20/98 Operation Permit by: Wesley Sparks R.S. date 4/22/99

Authorization to Construct by: Maria H. Dotson date 7/20/98 Existing System Inspection by: ____ date ____

HEALTH DEPT. COPY: WHITE INSPECTION COPY (FINAL): GREEN OWNER COPY (FINAL): YELLOW INSPECTION COPY (INITIAL): PINK OWNER COPY (INITIAL): GOLD