4655645659

IREDELL COUNTY HEALTH DEPARTMENT

STATESVILLE 704-878-5305 MOORESVILLE 704-664-5281

IMPROVEMENT PERMIT / CERTIFICATE OF COMPLETION / OPERATION PERMIT / EXISTING SYSTEM INSPECTION

PROPERTY DESCRIPTION NO. 22257 DATE 10/23/95 TAX MAP NO. 1D c 31 Pt Watershed: ☒ Yes ☐ No

OWNER OR CONTRACTOR Kenneth E. Hayes PHONE: Business Home 892-7881

ADDRESS 426 Faith Rd. Mooresville, NC. 28115

LOCATION 1.2 miles on (R) from Mecklenburg Hwy

SUBDIVISION N/A BLOCK / SECTION LOT LOT AREA 100 x 300 SITE CLASS. PS DESIGN FLOW 360 L.T.A.R. .25

Septic Tank: 1000 Gallons; STB 794 Date 8/7/95

Pump Tank: Gallons; PT Date

Pump Make: Model 1640 Serial No.

Nitrification Field: No Fields 1 Square Feet ~~1400~~ Linear Feet 480 ~~400~~

No Lines 5 Trench Width 36" Max Trench Bottom Depth 36" Gravel Depth 12"

☒ New System ☐ Repair System Type: I (II) III, IV, V, VI

System Description: Stalbo-Conventional

Repair System Description:

Maintenance Agreement Required: ☐ Yes ☐ No

☒ House/Mod. Home No. Bedrooms 3

☐ Mobile Home No. Bathrooms 2

☐ Business No. Employees

☐ Other


☐ Slab ☒ Crawl Space ☐ Basement w/plumbing ☐ Basement wo/plumbing

Water Supply:
☒ Individual
☐ Community
☐ Public
Forbes

Comments:

Comments:

INITIAL SITE SKETCH

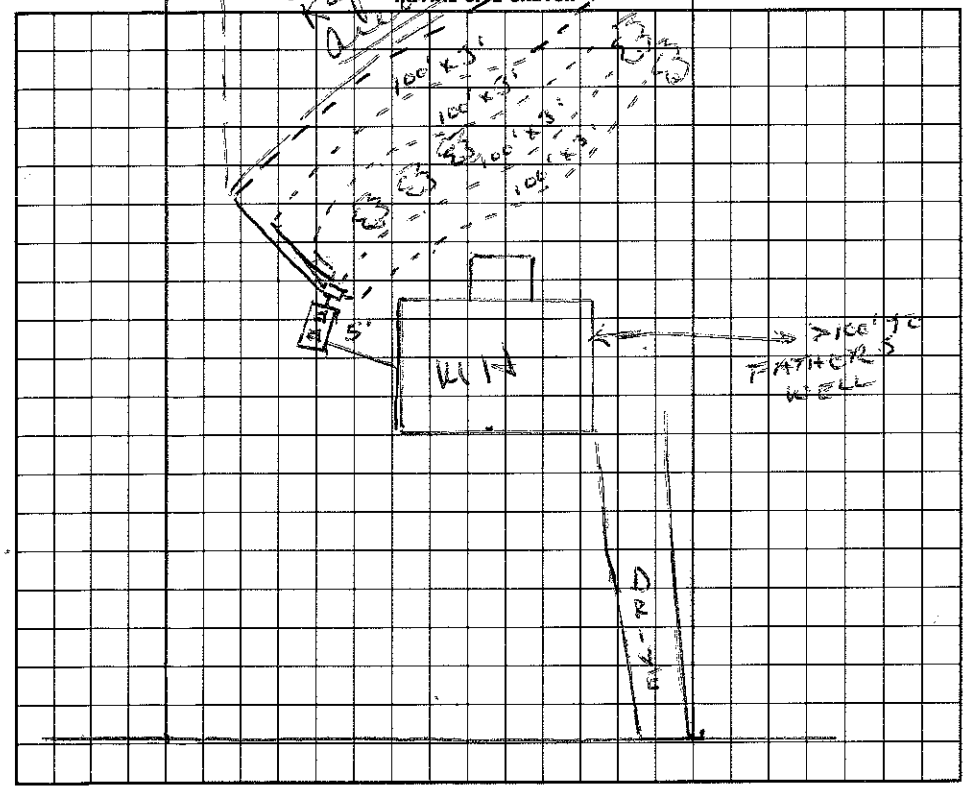

AS BUILT SKETCH

Installed as shown on Imp. Permit

I understand that this permit can be suspended or revoked if any false information is supplied toward securing the permit/any unauthorized changes are made to the site/any unauthorized changes are made in the installation of the system.

Signed: Kenneth E. Hayes

Improvement Permit by: Wesley Sparks RS date 10/23/95

~~Existing System Inspection by:~~ Department: Wesley Sparks RS date 10/23/95

Installed by: Codyco

Certificate of Completion by: date

Operation Permit by: Wesley Sparks RS. date 11/16/95

HEALTH DEPT. COPY: WHITE INSPECTION COPY (FINAL): GREEN OWNER COPY (FINAL): YELLOW INSPECTION COPY (INITIAL): PINK OWNER COPY (INITIAL): GOLD